

Manistee Co. ✓

LAND CORNER RECORDATION CERTIFICATE

FILING REQUIREMENT OF ACT 74, MICH. P.A.1970

FOR CORNERS OF--:	LOCATED IN--:	CORNER CODE NUMBER
1. PUBLIC LAND SURVEY _____ T. <u>24</u> ^N / _S , R. <u>15</u> ^E / _W .		B-11 C-11
2. PROPERTY CONTROLLING IN SECTION <u>31</u> , T. <u>24</u> ^N / _S , R. <u>15</u> ^E / _W .		Code 1
3. MISCELLANEOUS PROPERTY IN SECTION _____, T. _____, R. _____		
4. LOT NO. _____, RECORDED PLAT _____		
5. PRIVATE CLAIMS _____		

REGISTER OF DEEDS STAMP AND FILING NUMBER

I, Carl F. Roser do hereby certify that under requirements of P.A. 74, Michigan P.A. of 1970, the corner points mentioned in lines 1 and 2 above (identified with circles on index code diagram - over) were, in a field survey on 7-20 1972, established, re-established, monumented, re-monumented, recovered or restored as expressed below and in conformance with regulations and rules therefore as required in the current manual of survey instructions of the United States Department of the Interior, Bureau of Land Management or by a decree of a court of law. Furthermore, that the corner points mentioned in lines 3, 4 and 5 above were, in a field survey on _____ 19____, found, recovered, restored, established or re-established as expressed below and in conformance with the rules of the Michigan State Board of Registration for Land Surveyors or, by a Decree of a Court of law:

A. Description of original monument and accessories and/or subsequent restoration:

B. Description of corner evidence found and/or method applied in restoring or re-establishing corner:
B-11 Recovered 6" round (homemade) concrete mon. corner previously accepted and monumented by deceased RLS, Charlie Dodt.

C-11 Accepted 3/8" spike in surface of blacktop road as proper corner.

Code 1 Established corner per standard BLM directions.

C. Description of monument for corner and accessories established to perpetuate locating the position of the corner:

B-11	C-11	Code 1
Found 6" rd. conc. mon.	Fd 3/8" spike & strg. mag attr.	Set 1 1/4" x30" pipe & Maple post.
24" Maple S12E 16.82'	Power Pole N34W 120.38'	6" Maple N80W 10.8'
18" Maple N48W 49.52'	Fence or Post N82E 33.65'	(Loc. Tag
20" Maple N 7W 45.25'	12" B. Cherry S16W 174.70'	(12" Maple N 5W 4.1'
	On ctr. line N-S B. top Co. Rd.	7" W. Pine S13E 61.7'
		E-W Road Due S 0.60'


SIGNED BY Carl F. Roser DATE 12-4-72

SURVEYOR'S MICHIGAN REGISTRATION NO. 12028

FOR STATE AND UNITED STATES AGENCIES:

SIGNED BY _____ DATE _____
CHIEF OF SURVEY PARTY

APPROVED AND SIGNED BY _____ DATE _____
MICHIGAN REGISTERED LAND SURVEYOR

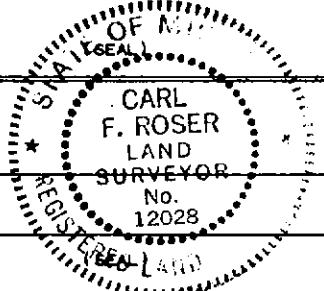

SURVEYOR'S MICHIGAN REGISTRATION NO. _____