

Manwister Coe

LAND CORNER RECORDATION CERTIFICATE

FILING REQUIREMENT OF ACT 74, MICH. P.A.1970

FOR CORNERS OF--:	LOCATED IN--:	CORNER CODE NUMBER
1. PUBLIC LAND SURVEY_____	T. <u>24</u> N. S. R. <u>15</u> W. W.	A-12 A-9 A-10
2. PROPERTY CONTROLLING IN SECTION_____	, T. _____ N. S., R. _____ E. W.	_____
3. MISCELLANEOUS PROPERTY IN SECTION_____	, T. _____ N. S., R. _____ E. W.	_____
4. LOT NO. _____, RECORDED PLAT _____		
5. PRIVATE CLAIMS _____		

REGISTER OF DEEDS STAMP AND FILING NUMBER

I, Carl F. Roser do hereby certify that under requirements of P.A. 74, Michigan P.A. of 1970, the corner points mentioned in lines 1 and 2 above (identified with circles on index code diagram - over) were, in a field survey on 7-19-72 19 , established, re-established, monumented, re-monumented, recovered or restored as expressed below and in conformance with regulations and rules therefore as required in the current manual of survey instructions of the United States Department of the Interior, Bureau of Land Management or by a decree of a court of law. Furthermore, that the corner points mentioned in lines 3, 4 and 5 above were, in a field survey on _____ 19 , found, recovered, restored, established or re-established as expressed below and in conformance with the rules of the Michigan State Board of Registration for Land Surveyors or, by a Decree of a Court of law:

A. Description of original monument and accessories and/or subsequent restoration:

B. Description of corner evidence found and/or method applied in restoring or re-establishing corner:

- A-9 Set corner per old County Road Commission Witnesses. Fits occupancy.
- A-10 Found 1 1/2" square iron and rocks. Accepted as proper corner.
- A-12 Recovered corner as 1"x30" pipe in line with dirt trail road to West as previously accepted and used by deceased RLS, Charlie Dodt.

C. Description of monument for corner and accessories established to perpetuate locating the position of the corner:

A-9	A-10	A-12
Set 1 1/2"x14" shaft with small gear on top in Ctr N-S B.top County Road.	Fd. 1 1/2" sq. Iron & rocks.	Found 1"x30" pipe. Set Sq top guard post
	30" Maple N 7W 148.41	9" Maple S16W 53.4'
	7" J. Pine S38E 52.2'	12" tw Maple S85E 46.4'
	6" J. Pine S 3 E 53.1'	8" Scth Pine N42W 52.0'
Ctr. Trail Rd. E Due N 5'	Fn. cor. Post N40W 26.4'	Ctr N-S dirt rd Due E 6'
F.A.S. con.mon N34E 56.4'	Ctr. E-W dirt	
Cor. Fn. Post Due W 38.4'	Co. Rd. Due S. 7'	
	Ctr Trail Rd S Due W 14'	


SIGNED BY Carl F. Roser DATE 12-4-72

SURVEYOR'S MICHIGAN REGISTRATION NO. 12028

FOR STATE AND UNITED STATES AGENCIES:

SIGNED BY _____ DATE _____
CHIEF OF SURVEY PARTY

APPROVED AND SIGNED BY _____ DATE _____
MICHIGAN REGISTERED LAND SURVEYOR

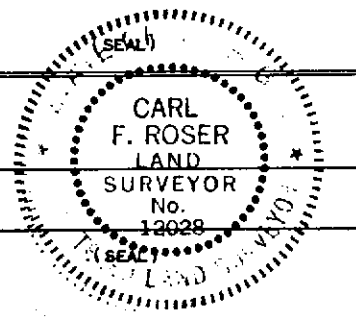

SURVEYOR'S MICHIGAN REGISTRATION NO. _____