

MANISZES Co.

# LAND CORNER RECORDATION CERTIFICATE

## FILING REQUIREMENT OF ACT 74, MICH. P.A.1970

FOR CORNERS OF--:	LOCATED IN--:	CORNER CODE NUMBER
1. PUBLIC LAND SURVEY	T. 24 <sup>N</sup> <del>W</del> R. 15 <sup>W</sup> <del>E</del>	
2. PROPERTY CONTROLLING IN SECTION 31	T. 24 <sup>N</sup> <del>W</del> R. 15 <sup>W</sup> <del>E</del>	Code 3
3. MISCELLANEOUS PROPERTY IN SECTION 31	T. 24 <sup>N</sup> <del>W</del> R. 15 <sup>W</sup> <del>E</del>	M.C. 1252.6' E of A-12 M.C. 1113.1' E of #3 on line bet. 3 & 4.
4. LOT NO. _____, RECORDED PLAT _____		
5. PRIVATE CLAIMS _____		

REGISTER OF DEEDS STAMP AND FILING NUMBER

I, Carl F. Roser do hereby certify that under requirements of P.A. 74, Michigan P.A. of 1970, the corner points mentioned in lines 1 and 2 above (identified with circles on index code diagram - over) were, in a field survey on 7-19 1972, established, re-established, monumented, re-monumented, recovered or restored as expressed below and in conformance with regulations and rules therefore as required in the current manual of survey instructions of the United States Department of the Interior, Bureau of Land Management or by a decree of a court of law. Furthermore, that the corner points mentioned in lines 3, 4 and 5 above were, in a field survey on 9-11 1972, found, recovered, restored, established or re-established as expressed below and in conformance with the rules of the Michigan State Board of Registration for Land Surveyors or, by a Decree of a Court of law:

A. Description of original monument and accessories and/or subsequent restoration:

B. Description of corner evidence found and/or method applied in restoring or re-establishing corner:

Code 3 Established corner per standard BLM directions.

MC. E A-12 Recovered 1" pipe. Corner previously accepted and used by deceased RLS, Charlie Dodt. Point on E-W 1/4 line on W. Shore of Bear Lake.

MC. E of #3 Established corner per standard BLM directions. Point on N. Line of Govt. Lot 4. near West shore of Bear Lake.

C. Description of monument for corner and accessories established to perpetuate locating the position of the corner:

Code 3			M.C. E A-12			M.C. E of #3		
Set 1 1/2"x48" pipe & post location tag			Fd. 1" pipe, set sq. post			Set 1"x36" pipe & Tam. guard post		
4" W. Pine	N70E	34.9'	22" W. Pine	S41W	31.60'	5" Tamarack	N26W	15.2'
7" Tamarack	N83W	23.5'	30" W. Pine	N26W	45.90'	6" Tamarack	N75E	18.5'
9" Tamarack	S 5W	22.1'	Waters Edge	Due E	35'	6" Tamarack	S36E	8.6'


SIGNED BY Carl F. Roser DATE 12-4-72

SURVEYOR'S MICHIGAN REGISTRATION NO. 12028

FOR STATE AND UNITED STATES AGENCIES:

SIGNED BY \_\_\_\_\_ DATE \_\_\_\_\_  
CHIEF OF SURVEY PARTY

APPROVED AND SIGNED BY \_\_\_\_\_ DATE \_\_\_\_\_  
MICHIGAN REGISTERED LAND SURVEYOR

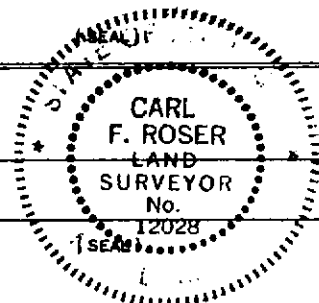

SURVEYOR'S MICHIGAN REGISTRATION NO. \_\_\_\_\_