

OCT 03 2000

LAND CORNER RECORDATION CERTIFICATE

Filing Requirement of Act 74, Mich. P.A. 1970

For corners in

SECTION

REGISTER'S OFFICE
MANISTEE COUNTY

00-283 at 10:35 p.m.
SEP 03 2000

Romy A. Repas
REGISTER OF DEEDS

Register of Deeds Stamp & File
Number


<u>Manistee</u> (County)	Located In:	Corner Code #
1. Public Land Survey	T <u>24N</u> R <u>15W</u>	C-01 ✓
	T _____ R _____	NE Sec Corner
	T _____ R _____	Sec 6
	T <u>25N</u> R <u>15W</u>	C-13
2. Property Controlling in Section	S _____ T _____ R _____	SE Sec Corner
	S _____ T _____ R _____	Sec 31
3. Miscellaneous Property in Sec.	S _____ T _____ R _____	
	S _____ T _____ R _____	
4. Lot No. _____, Recorded Plat _____		
5. Private Claims _____		

I, Anthony M. Slawinski, in a field survey on June 29, 20 00 do hereby state that under requirements of P.A. 74, Michigan P.A. of 1970, the corner points mentioned in lines 1 and 2 above were in conformance with regulations and rules therefore as required in the current manual of survey instructions of the United States Department of the Interior, Bureau of Land Management or by a decree of a Court of Law and /or that the corner points mentioned in lines 3, 4 and 5 above were in conformance with the rules of the Michigan Board of Land Surveyors or by a Decree of a Court of Law; established, re-established, monumented, recovered, found as expressed below:

NOTE: Not more than 2 corners, all in the same town and range, may be recorded on this certificate.

A. Description of original monument and accessories and/or subsequent restoration:
Northeast Corner of Section 6 (24-15) & Southeast Corner of Section 31 (25-15)
Set by John Brink in 1838.

1. Beech 8" in dia. N 30 1/2° W 23 links (15.18')
2. Beech 10" in dia. N 76° E 43 links (28.38')
3. Sugar 13" in dia. S 28° W 52 links (34.32')
4. Sugar 12" in dia. N 79° W 17 links (11.22')

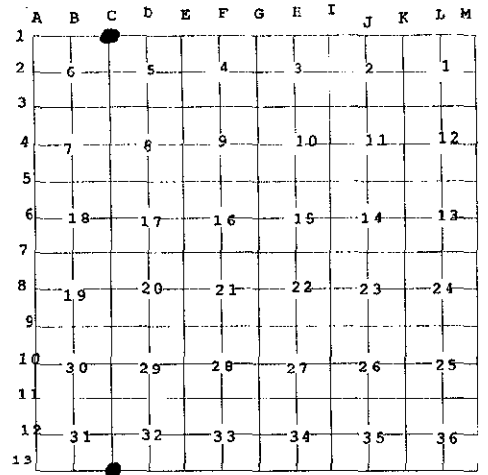

B. Description of corner evidence found and/or method applied in restoring or reestablishing corner:
Northeast Corner of Section 6 (24-15) & Southeast Corner of Section 31 (25-15)
On June 29, 2000, I, Anthony M. Slawinski along with a field crew from Abonmarche found a 1/2" x 18" iron rod over an old iron pump handle. While digging in the hole we found flagging, golf balls, a doorknob and some small bolts. We found no other evidence to dispute this location for the corner.

Condition of witnesses: #1 gone, #2 gone, #3 gone & #4 gone

C. Description of monument for corner and accessories established to perpetuate locating the position of the corner:
Northeast Corner of Section 6 (24-15) & Southeast Corner of Section 31 (25-15)

On June 29, 2000, I installed a Manistee County Monument, within a monument box, in the exact location of the above mentioned iron rod and pump handle as a careful and faithful re-establishment of the position of the original corner, and witnessed by:

5. N 03° E 63.90' 30" Maple (set 40d spike in W. side of tree)
6. N 66° E 85.32' 36" Maple (fd. 60d spike on SE side of tree)
7. S 26° E 59.14' 10" Jack Pine (fd. 40d spike on W, side of tree)
8. S 65° E 85.19' 8" Jack Pine (Set 40d spike on N. side of tree)

The corner is in the centerline centerline intersection of Taylor Road and Kellor Road.

Corner C - 01 ratified by the Manistee County Peer Group according to the county plan adopted pursuant to P.A. 345 of 1990, as amended, (being the State Survey and Remonument Act, MCL 54.231 et seq.). Date of Peer Review: 7-31-00

Anthony M. Slawinski

Signed by *Anthony M. Slawinski*
Surveyor's Michigan License No. 13597



Date 7-27-00