

LAND CORNER RECORDATION CERTIFICATE
Filing Requirement of Act 74, Mich. P.A. 1970

For corners in

Manistee (County) Located In: Corner Code #
1. Public Land Survey T24N R 15W E-01 NE Sec Corner Sec 5
2. Property Controlling in Section S T R SE Sec Corner Sec 32
3. Miscellaneous Property in Sec. S T R
4. Lot No. , Recorded Plat
5. Private Claims

REGISTER'S OFFICE
MANISTEE COUNTY
00-284 at 10:40p.m.
SEP 03 2000
Penny A. Repora
REGISTER OF DEEDS

Register of Deeds Stamp & File Number

I, Anthony M. Slawinski, in a field survey on June 29, 20 00 do hereby state that under requirements of P.A. 74, Michigan P.A. of 1970, the corner points mentioned in lines 1 and 2 above were in conformance with regulations and rules therefore as required in the current manual of survey instructions of the United States Department of the Interior, Bureau of Land Management or by a decree of a Court of Law and /or that the corner points mentioned in lines 3, 4 and 5 above were in conformance with the rules of the Michigan Board of Land Surveyors or by a Decree of a Court of Law; established, re-established, monumented, recovered, found as expressed below:

NOTE: Not more than 2 corners, all in the same town and range, may be recorded on this certificate.

A. Description of original monument and accessories and/or subsequent restoration:
Northeast Corner of Section 5 (24-15) & Southeast Corner of Section 32 (25-15)
Set by John Brink in 1838.

- 1. Beech 8" in dia. N 14 1/2° W 47 links (31.02')
2. Beech 8" in dia. N 43° E 35 links (23.10')

B. Description of corner evidence found and/or method applied in restoring or reestablishing corner:
Northeast Corner of Section 5 (24-15) & Southeast Corner of Section 32 (25-15)

On June 29, 2000, I, Anthony M. Slawinski, along with a field crew from Abonmarche, found a 1/2" x 18" iron rod w/cap #25875 (Stowe) & #21588 (Kelly) over a 1" iron pipe which was directly over a cluster of 4 - 1" pipes. The 4 pipes were all within a diameter of 0.25'. The raised pipe and rod were centered on the middle of this cluster. We accepted the location of the 1/2" iron rod. We found no other evidence to dispute this location for the corner. Stowe & Kelly were contacted twice & provided no information as of 7-31-00.

Condition of witnesses: #1 gone & #2 gone

C. Description of monument for corner and accessories established to perpetuate locating the position of the corner:
Northeast Corner of Section 5 (24-15) & Southeast Corner of Section 32 (25-15)


On June 29, 2000, I installed a Manistee County Monument in the exact location on the above mentioned 1/2" iron rod, 1" iron pipe and 4 pipe cluster as a careful and faithful re-establishment of the position of the original corner, and witnessed by:

- 3. N 80° E 65.45' 34" Beech (fd. 60d spike flush with the bark, set 40d spike directly above on S side of tree)
4. East 33.00' Found iron rod w/cap #24617 by 3-D Surveying
5. S 42° E 35.17' 24" Triple Black Walnut (set 40d spike on SW side of tree)
6. N 10° W 71.80' 8" Ash (set 40d spike in E side of tree)

Corner is in the centerline, centerline intersection of Taylor Road and Butwell Road.

Corner E-01 ratified by the Manistee County Peer Group according to the county plan adopted pursuant to P.A. 345 of 1990, as amended, (being the State Survey and Monument Act, MCL 54.261 et seq.). Date of Peer Review: 7-31-00
Anthony M. Slawinski

Signed by Anthony M. Slawinski
Surveyor's Michigan License No. 13597

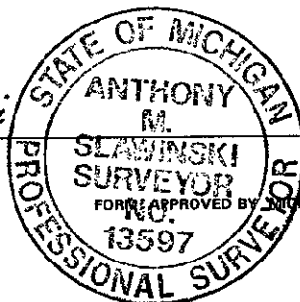

Date 7-26-00

Grid table with columns A-M and rows 1-13. A dot is marked at the intersection of column E and row 1.