

SURVEY
REMONUM

MAY 1

LAND CORNER RECORDATION CERTIFICATE

Filing Requirement of Act 74, Mich. P.A. 1970

For corners in MANISTEE Located In: _____ Corner Code # _____
 (County)

1. Public Land Survey T 24 / R 15W E-5
 T _____ R _____
 T _____ R _____
 T _____ R _____

2. Property Controlling S _____ T _____ R _____
 in Section S _____ T _____ R _____

3. Miscellaneous S _____ T _____ R _____
 Property in Sec. S _____ T _____ R _____

4. Lot No. _____ Recorded Plat _____

5. Private Claims _____

REGISTER'S OFFICE
 MANISTEE COUNTY
 #96-361 at 9:50 A.M.
 AUG 23 1996
Penny A. Perna
 REGISTER OF DEEDS

Register of Deeds Stamp & File Number

I, Kenneth L. Ross, in a field survey on July 24, 1996, do hereby certify that under requirements of P.A. 74, Michigan P.A. of 1970, the corner points mentioned in lines 1 and 2 above were in conformance with regulations and rules therefore as required in the current manual of survey instructions of the United States Department of the Interior, Bureau of Land Management or by a decree of a Court of Law and/or that the corner points mentioned in lines 3, 4 and 5 above were in conformance with the rules of the Michigan Board of Land Surveyors or by a Decree of a Court of Law, established, re-established, monumented, re-monumented, recovered, found as expressed below:

NOTE: Not more than 4 corners, all in the same town and range, may be recorded on this certificate.

A. Description of original monument and accessories and/or subsequent restoration:

E-5 Sec. Cor., 8, 9, 16, & 17-24-15
 1839 John Brink
 (1) 6" Beech S 71 W 54 lks
 (2) 14" Beech S 31 E 57 lks

1	A	B	C	D	E	F	G	H	I	J	K	L	M
2	6	5	4	3	2	1							
3													
4	7	8	9	10	11	12							
5			*										
6	18	17	16	15	14	13							
7													
8	19	20	21	22	23	24							
9													
10	30	29	28	27	26	25							
11													
12	31	32	33	34	35	36							
13													

B. Description of corner evidence found and/or method applied in restoring or reestablishing corner:

E-5 Sec. Cor., 8, 9, 16, & 17-24-15
 Dec., 1988, Slawinski Rd. 1" Square Head Bolt (Liber 2 of Survey, Page 49)
 Jul., 1996, K. Ross Rd. 1" Iron Pipe, CL N-S & E-W Roads

Corner E-05 ratified by the Manistee County Peer Group according to the county plan adopted pursuant to P.A. 345 of 1990, as amended, (being the State Survey and Remonument Act, MCL 54.261 et. seq.). Date of Peer Review: AUG 6 1996


Anthony M. Slawinski

C. Description of monument for corner and accessories established to perpetuate locating the position of the corner:

E-5 Sec. Cor., 8, 9, 16, & 17-24-15
 Witness 1 & 2 gone.

Replaced 1" Iron Pipe with Standard Manistee County Monument in monument box, and is accepted as the best available evidence of the original corner.

- (3) Buried Cable Warning Post S 55 W 60.96'
- (4) Buried Cable Warning Post S 53 E 59.51'
- (5) 4" R. Pine N 45 E 63.71' (Spike)
- (6) 12" R. Pine S 31 E 74.26' (Spike)

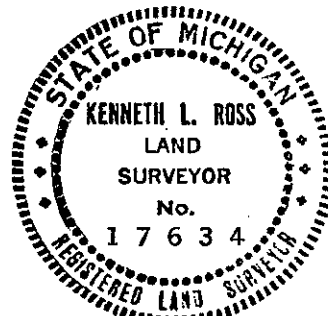

Signed by *K. L. Ross* 8-5-96 Date

Surveyor's Michigan License No. 17634