

JUL 13 2000

LAND CORNER RECORDATION CERTIFICATE  
Filing Requirement of Act 74, Mich. P.A. 1970

For corners in

<u>Manistee</u> (County)	Located In:	Corner Code #
1. Public Land Survey	T <u>24N</u> R <u>15W</u>	<u>K-13</u>
	T _____ R _____	<u>SE Sec. Cor.</u>
	T _____ R _____	<u>Sec. 35</u>
	T _____ R _____	_____
2. Property Controlling in Section	S _____ T _____ R _____	_____
	S _____ T _____ R _____	_____
3. Miscellaneous Property in Sec.	S _____ T _____ R _____	_____
	S _____ T _____ R _____	_____
4. Lot No. _____, Recorded Plat _____		
5. Private Claims _____		

REGISTER'S OFFICE  
MANISTEE COUNTY  
00-287 at 10:47p.m.  
SEP 03 2000  
Penny A. Pepera  
REGISTER OF DEEDS

Register of Deeds Stamp & File Number

I, Anthony M. Slawinski, in a field survey on June 29, 20 00 do hereby state that under requirements of P.A. 74, Michigan P.A. of 1970, the corner points mentioned in lines 1 and 2 above were in conformance with regulations and rules therefore as required in the current manual of survey instructions of the United States Department of the Interior, Bureau of Land Management or by a decree of a Court of Law and /or that the corner points mentioned in lines 3, 4 and 5 above were in conformance with the rules of the Michigan Board of Land Surveyors or by a Decree of a Court of Law; established, re-established, monumented, recovered, found as expressed below:

NOTE: Not more than 2 corners, all in the same town and range, may be recorded on this certificate.

A. Description of original monument and accessories and/or subsequent restoration:

Southeast Section Corner Section 35 (24-15)  
Set by Brink in 1838

1. Black Ash 14" in dia. N 61° E 37 links (24.42')
2. Black Ash 12" in dia. N 29° W 40 links (26.40')

Closing corner for (23-15) was set by Brink 125 links (82.50') East of Southeast corner of Section 35 (24-15)

Manistee County Surveyor Records Book A, Page 193  
Unknown Surveyor, undated  
No monument stated

3. Cedar 18" in dia. N 69½° E 67 links (44.22')

Certificate of Survey by Bruning RLS #10681 in 1978 (L. 1 surveys, p 529 & 530)  
Set Iron using GLO instructions  
SW Cor. ½" Iron Pipe fd.

4. Maple 15" in dia. N 59° W 78.53'
5. Ash 7" in dia. N 53° W 58.34'
6. Ash 12" in dia. N 70° E 102.50'
7. 1" Iron Pipe East 82.50'

B. Description of corner evidence found and/or method applied in restoring or reestablishing corner:

Southeast Section Corner Section 35 (24-15)  
On June 29, 2000, I Anthony M. Slawinski, along with a field crew from Abonmarche, found a ½" x 18" iron rod, in a monument box, over a ½" iron pipe. We found no other evidence to dispute this location for the corner.

Condition of witnesses: # 1 gone, #2 gone, #3 gone, #4 gone, #5 gone, #6 gone & #7 good

C. Description of monument for corner and accessories established to perpetuate locating the position of the corner:

Southeast Section Corner Section 35 (24-15)  
On June 29, 2000, I installed a Manistee County Monument, within a monument box, in the exact location as the above mentioned ½" rod and ½" pipe as a careful and faithful re-establishment of the position of the original corner, and witnessed by:


8. N 63° E 80.84' 30" Twin Ash (fd 60d spike on SE side of tree)
9. South 24.49' Power Pole (fd 60d spike on E side of pole)
10. N 41° W 70.12' 12" Ash (fd 40d spike on E side of tree)
11. North 41.50' ½" iron rod w/cap #10681 (Bruning)

The corner is in the centerline of 13 Mile Road, and the closing corner for T23N, R15W is East, 82.50'. Witness #7

	A	B	C	D	E	F	G	H	I	J	K	L	M
1													
2	6		5		4		3		2		1		
3													
4	7		8		9		10		11		12		
5													
6	18		17		16		15		14		13		
7													
8	19		20		21		22		23		24		
9													
10	30		29		28		27		26		25		
11													
12	31		32		33		34		35		36		
13													

Corner K = 1 3 ratified by the Manistee County Peer Group according to the county plan adopted pursuant to P.A. 345 of 1990, as amended, (being the State Survey and Remonument Act, MCL 54.231 et seq.). Date of Peer Review: 7-31-00

Anthony M. Slawinski

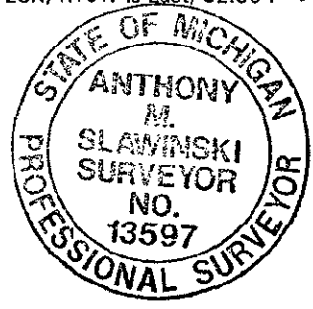

Signed by Anthony M. Slawinski  
Surveyor's Michigan License No. 13597

Date 7-26-00