

OCT 03 2000

SECTION

LAND CORNER RECORDATION CERTIFICATE Filing Requirement of Act 74, Mich. P.A. 1970

For corners in

<u>Manistee</u> (County)	Located In:	Corner Code #
1. Public Land Survey	T <u>24N</u> R <u>15W</u>	<u>L-13</u>
	T _____ R _____	<u>s ¼ Sec. 36</u>
	T _____ R _____	_____
	T _____ R _____	_____
2. Property Controlling in Section	S _____ T _____ R _____	_____
	S _____ T _____ R _____	_____
3. Miscellaneous Property in Sec.	S _____ T _____ R _____	_____
	S _____ T _____ R _____	_____
4. Lot No. _____, Recorded Plat _____		
5. Private Claims _____		

**REGISTER'S OFFICE
MANISTEE COUNTY**
00-288 at 10:50p.m.
SEP 03 2000
Penny A. Pepera
REGISTER OF DEEDS

Register of Deeds Stamp & File Number

I, Anthony M. Slawinski, in a field survey on June 29, 2000 do hereby state that under requirements of P.A. 74, Michigan P.A. of 1970, the corner points mentioned in lines 1 and 2 above were in conformance with regulations and rules therefore as required in the current manual of survey instructions of the United States Department of the Interior, Bureau of Land Management or by a decree of a Court of Law and /or that the corner points mentioned in lines 3, 4 and 5 above were in conformance with the rules of the Michigan Board of Land Surveyors or by a Decree of a Court of Law; established, re-established, monumented, recovered, found as expressed below:

NOTE: Not more than 2 corners, all in the same town and range, may be recorded on this certificate.

A. Description of original monument and accessories and/or subsequent restoration:
South ¼ Corner of Section 36 (24-15)
Set by John Brink in 1838
10" Birch at corner location

Manistee County Surveyor's Record
E.D.M. in 1912 Book A, Page 294
No monument stated

1. Ash Clump 16" in dia. N 05° W 38 ½ links (25.41')

Survey Cert. By Bruning RLS #10681 in 1978
Fd. ½" iron pipe *Rec. L. 1 surveys, p. 529 + 530*
2. Ash 12" N 70° W 89.04'
3. Ash 12" N 60° W 61.41'
4. Ash 12" N 37° W 43.45'
5. Ash 12" East 41.21'


B. Description of corner evidence found and/or method applied in restoring or reestablishing corner:
South ¼ Corner of Section 36 (24-15)
On June 29, 2000, I Anthony M. Slawinski, along with a field crew from Abonmarche, found a ½" x 18" iron rod in a monument box. We found no other evidence to dispute this location for the corner.

Condition of witnesses: # 1 gone, #2 gone, #3 gone, #4 gone & #5 gone.

C. Description of monument for corner and accessories established to perpetuate locating the position of the corner:
South ¼ Corner of Section 36 (24-15)
On June 29, 2000, I installed a Manistee County Monument in the exact location as the above mentioned ½" rod as a careful and faithful re-establishment of the position of the original corner, and witnessed by:

- 6. S 47° E 60.21' Power Pole (fd. 60d spike in NE side of pole)
- 7. N 12° W 49.64' 8" Cedar (fd. 40d spike in E side of tree)
- 8. North 32.49' Found Iron rod W/cap # 10681 (Bruning)
- 9. S 05° E 30.05' 18" steel culvert (measured to the top, center of the pipe)

The corner is in the centerline of 13 Mile Road (Co. Rd. 600). Corner fits occupation fence line to the North. The North of Corner (T23N, R15W) is East 41.25' of this corner.

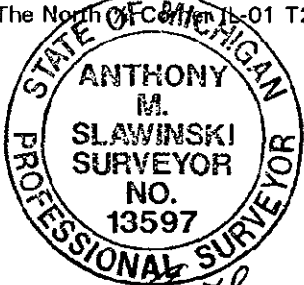

Signed by Anthony M. Slawinski
Surveyor's Michigan License No. 13597

	A	B	C	D	E	F	G	H	I	J	K	L	M
1													
2	6		5		4		3		2		1		
3													
4	7		8		9		10		11		12		
5													
6	18		17		16		15		14		13		
7													
8	19		20		21		22		23		24		
9													
10	30		29		28		27		26		25		
11													
12	31		32		33		34		35		36		
13													

Ratified by the Manistee County Peer Group
 according to the county plan adopted pursuant to P.A. 345 of 1990,
 as amended, (being the State Survey and Monument Act, MCL 54.261
 et seq.). Date of Peer Review: 7-31-00
Anthony M. Slawinski

Date 7-26-00