

OCT 15 2000

SECTION

LAND CORNER RECORDATION CERTIFICATE

Filing Requirement of Act 74, Mich. P.A. 1970

For corners in

Manistee _____ (County)	Located In:	Corner Code #
1. Public Land Survey	T 24N R 16W	I-01
	T _____ R _____	NE Sec Corner
	T _____ R _____	Sec 3
	T _____ R _____	
2. Property Controlling in Section	S _____ T _____ R _____	
	S _____ T _____ R _____	
3. Miscellaneous Property in Sec.	S _____ T _____ R _____	
	S _____ T _____ R _____	
4. Lot No. _____, Recorded Plat _____		
5. Private Claims _____		

REGISTER'S OFFICE  
MANISTEE COUNTY

00-277 at 10:30 p.m.  
SEP 03 2000

*Ammy A. Kora*  
REGISTER OF DEEDS

Register of Deeds Stamp & File  
Number

I, Anthony M. Slawinski, in a field survey on June 22, 2000 do hereby state that under requirements of P.A. 74, Michigan P.A. of 1970, the corner points mentioned in lines 1 and 2 above were in conformance with regulations and rules therefore as required in the current manual of survey instructions of the United States Department of the Interior, Bureau of Land Management or by a decree of a Court of Law and /or that the corner points mentioned in lines 3, 4 and 5 above were in conformance with the rules of the Michigan Board of Land Surveyors or by a Decree of a Court of Law; established, re-established, monumented, recovered, found as expressed below:

**NOTE: Not more than 2 corners, all in the same town and range, may be recorded on this certificate.**

A. Description of original monument and accessories and/or subsequent restoration:  
Northeast Corner of Section 3 (24-16) & Southeast Corner of Section 34 (25-16)  
Set by John Brink in 1838.  
80.60 (chains) (5319.60') Intersect North Boundary 25 links (16.5') East of Post

Manistee County Surveyor's Record, Book A, Page 302  
Set Iron pipe by J.H. Millard in 1921.  
Fd. Brink's stake.

1. Sugar 12" in dia. N 15° E 40 1/2 links (26.73')
2. Sugar 10" in dia. N 39° W 42 1/2 links (28.05')

Certificate of Survey by Glenn F. De La Mater RLS #13030, in 1988  
Iron size and type not stated  
No Witnesses stated.

B. Description of corner evidence found and/or method applied in restoring or reestablishing corner:  
Northeast Corner of Section 3 (24-16) & Southeast Corner of Section 34 (25-16)  
On June 22, 2000, I, Anthony Slawinski, along with a field crew from the Abonmarche Group found a 2" well point, 39" long. We found no other evidence to dispute this location for the corner.

Condition of witnesses: #1 good, #2 good

C. Description of monument for corner and accessories established to perpetuate locating the position of the corner:  
Northeast Corner of Section 3 (24-16) & Southeast Corner of Section 34 (25-16)  
On June 22, 2000, I set a Manistee County Monument, 6" below grade on the South side of a two-track in the exact location as the above mentioned 2" pipe as a careful and faithful perpetration of the position of the original corner, and witnessed by:


1. N 23° E 26.74' 30" Maple (set 60d on east side of tree)
2. N 31° W 28.78' 30" Maple (fd. 60d on east side of tree)
3. S 45° W 9.55' 17" Elm (fd. 60d on east side of tree)
4. N 12° E 23.00' 14" Maple (fd. 60d on west side of tree)

Corner is on South side of a 2-track (Taylor Road). The Southeast corner of section 34 (25-16) is West 16.50'.

Corner I-01 ratified by the Manistee County Peer Group according to the county plan adopted pursuant to P.A. 345 of 1990, as amended, (being the State Survey and Remonument Act, MCL 54.261 et seq.). Date of Peer Review: 7-31-00  
*Anthony M. Slawinski*

Signed by *Anthony M. Slawinski*  
Surveyor's Michigan License No. 13597

Date 7-27-00

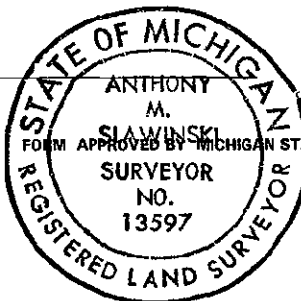

	A	B	C	D	E	F	G	H	I	J	K	L	M
1									●				
2	6			5			4		3			2	1
3													
4	7			8			9		10		11		12
5													
6	18			17			16		15		14		13
7													
8	19			20			21		22		23		24
9													
10	30			29			28		27		26		25
11													
12	31			32			33		34		35		36
13													