

JUL 14 1994

COMMISSION

LAND CORNER RECORDATION CERTIFICATE
Filing Requirement of Act 74, Mich. P.A. 1970

For corners in
MANISTEE

(County)

Located In:

Corner Code #

- | | | | | | |
|---------------------------------------|---|-----|---|-----|-----|
| 1. Public Land Survey | T | 24N | R | 16W | I-2 |
| | T | | R | | |
| | T | | R | | |
| | T | | R | | |
| 2. Property Controlling
in Section | S | | T | R | |
| | S | | T | R | |
| 3. Miscellaneous
Property in Sec. | S | | T | R | |
| | S | | T | R | |

REGISTER'S OFFICE
MANISTEE COUNTY

#94-288 At 4:25 p.m.

JUN 23 1994

Penny A. Pepera
REGISTER OF DEEDS

Register of Deeds Stamp & File Number

4. Lot No. _____, Recorded Plat _____
5. Private Claims _____

Richard L. Hays

April 14, 1994

I, Richard L. Hays, in a field survey on April 14, 1994, do hereby certify that under requirements of P.A. 74, Michigan P.A. of 1970, the corner points mentioned in lines 1 and 2 above were in conformance with regulations and rules therefore as required in the current manual of survey instructions of the United States Department of the Interior, Bureau of Land Management or by a decree of a Court of Law and/or that the corner points mentioned in lines 3, 4 and 5 above were in conformance with the rules of the Michigan Board of Land Surveyors or by a Decree of a Court of Law; established, re-established, monumented, re-monumented, recovered, found as expressed below:

NOTE: Not more than 4 corners, all in the same town and range, may be recorded on this certificate.

	A	B	C	D	E	F	G	H	I	J	K	L	M
2	6		5		4		3	●	2		1		
3													
4	7		8		9		10		11		12		
5													
6	13		17		16		15		14		13		
7													
8	19		20		21		22		23		24		
9													
10	30		29		28		27		26		25		
11													
12	31		32		33		34		35		36		
13													

A. Description of original monument and accessories and/or subsequent restoration:

I-2 QUARTER CORNER COMMON TO SECTIONS 2 & 3

1839:G.L.O. 1983:Corner Set by Carl Shawgraw (#25872)

10" Beech N-81°-W 11 Lks
6" Hemlock N-53°-W 26 Lks

1988:Glen F. De La Mater

Set 1/2" Iron with cap

10" Ash S-12°-W 18.35'

Maple S-65°-W 7.19'

18" Oak N-10°-W 12.72'

1921:Millard Survey-Set
Iron & Stone

17" Sugar S-52°-E 27 Lks

15" Sugar S-16°-E 32 Lks

1986:Rev 1992 A. Slawinski Survey

used Carl Shawgraw Iron (#25872)

12" B. Oak East 20.50'

8" Hornbean N-05°-W 6.71'

8" Hornbean S-45°-W 7.80'

1/2" Iron

B. Description of corner evidence found and/or method applied in restoring or reestablishing corner:

I-2 QUARTER CORNER COMMON TO SECTIONS 2 & 3

1993:Found Corner set by Carl Shawgraw and Glen F. De La Mater with witnesses. Could not find the G.L.O. or the Millard Corner. Used the corner set by Carl Shawgraw which fits the occupation as the best position for the corner

C. Description of monument for corner and accessories established to perpetuate locating the position of the corner:


I-2 QUARTER CORNER COMMON TO SECTIONS 2 & 3

1994:Replaced 1/1" Re-Rod with cap #25872 set by Carl Shawgraw with the Standard Manistee Monument with Brass Cap and is accepted as the best available evidence of the position of the Original Corner.

Corner I - 2 - ratified by the Manistee County Peer Group according to the county plan adopted pursuant to P.A. 345 of 1990, as amended, (being the State Survey and Remonument Act, MCL 54.261 et seq.). Date of Peer Review: 5/4/94 *Richard L. Hays*

Signed by *Richard Hays*

Surveyor's Michigan License No. 25847

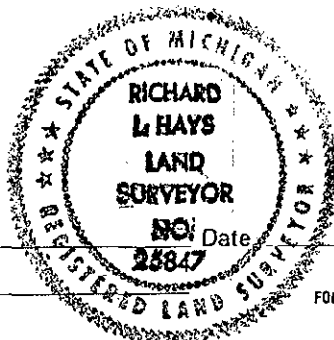

5/2/94