

JUL 15 2000

SECTION LAND CORNER RECORDATION CERTIFICATE Filing Requirement of Act 74, Mich. P.A. 1970

For corners in

Manistee (County) Located In: Corner Code # 1. Public Land Survey T 24N R 16W K-01 NE Sec Cor Sec 2

REGISTER'S OFFICE MANISTEE COUNTY 00-279 at 10:25 p.m. SEP 03 2000 Penny A. Repora REGISTER OF DEEDS

Register of Deeds Stamp & File Number

I, Anthony M. Slawinski, in a field survey on June 22, 2000 do hereby state that under requirements of P.A. 74, Michigan P.A. of 1970, the corner points mentioned in lines 1 and 2 above were in conformance with regulations and rules therefore as required in the current manual of survey instructions of the United States Department of the Interior, Bureau of Land Management or by a decree of a Court of Law and /or that the corner points mentioned in lines 3, 4 and 5 above were in conformance with the rules of the Michigan Board of Land Surveyors or by a Decree of a Court of Law; established, re-established, monumented, recovered, found as expressed below:

NOTE: Not more than 2 corners, all in the same town and range, may be recorded on this certificate.

A. Description of original monument and accessories and/or subsequent restoration: Northeast Corner of Section 2 (24-16) Set by John Brink in 1838 80.54 (chains) (5315.64') Intersect North Boundary 13 links (8.58') East of Post

Manistee County Surveyor's Record E.D.M. in 1915 Book A, Page 301 No Monument stated 1. Maple 5" in dia. S 50° E 47 links (31.02')

P.A. 74 form by De La Mater RLS #13030 in 1988 Fd. 2" iron pipe Rec. (86-632) 1. S 48° E 31.85' 14" Maple 2. S 45° W 10.35' 8" Triple Maple 3. N 20° W 14.77' 10" Maple 4. S 45° E 15.50' 8" Basswood

Cert. & Notes by Slawinski in 1989 Fd. 2" iron pipe 2. S 45° W 10.36' 14" Maple 3. N 15° W 14.74' 12" Maple 4. S 45° E 15.52' 12" Basswood

Cert. By Slawinski in 1992 Fd. 2" iron pipe 1. S 45° E 31.84' 14" Maple 2. S 45° W 10.36' 14" maple 3. N 15° W 14.74' 12" Maple 4. S 45° E 15.52' 12" Basswood

B. Description of corner evidence found and/or method applied in restoring or reestablishing corner: Northeast Corner of Section 2 (24-16) On June 22, 2000, I, Anthony Slawinski, along with a field crew from the Abonmarche Group found A 2" pipe, 2.15' long. The crew found no other evidence to dispute this location for the corner.

Condition of witnesses: #1 good, #2 good, #3 fd. stump with nail, #4 gone (fd. rotted stump)

C. Description of monument for corner and accessories established to perpetuate locating the position of the corner: Northeast Corner of Section 2 (24-16) On June 22, 2000, I set a Manistee County Monument 6" above grade, in the exact location as the above mentioned 2" pipe as a careful and faithful re-establishment of the position of the original corner, and witnessed by:


- 1. S 48° E 31.84' 21" Maple (fd. 60d in south side of tree) 2. S 45° W 10.36' 18" Maple (fd. 60d in east side of tree) 5. North 9.64' 7" Maple (set 60d in west side of tree) 6. West 17.90' 18" Maple (set 60d in north side of tree)

Corner is ± 6" above grade and fits with occupation - fence line runs East from Corner. No evidence of Benzie County Corner was found.

Grid table with columns A-M and rows 1-13. A dot is marked at the intersection of column K and row 1.

Corner K-0-1 according to the county plan adopted pursuant to P.A. 345 of 1990, et seq.). Date of Peer Review: 7-31-00 Anthony M. Slawinski ratified by the Manistee County Peer Group

Signed by Anthony M. Slawinski Surveyor's Michigan License No. 13597

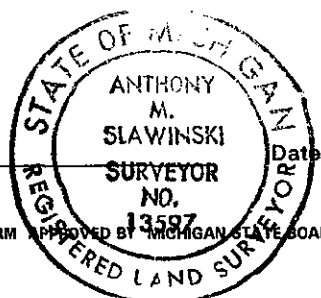

Date 7-27-00