

MAY 16 1997

COMMISSION

LAND CORNER RECORDATION CERTIFICATE

Filing Requirement of Act 74, Mich. P.A. 1970

For corners in

MANISTEE

(County)

Located In:

Corner Code #

1. Public Land Survey	T	24N	R	16W	K-7
	T		R		
	T		R		
	T		R		
2. Property Controlling in Section	S		T	R	
	S		T	R	
3. Miscellaneous Property in Section	S		T	R	
	S		T	R	

REGISTER'S OFFICE
MANISTEE COUNTY

96-412 at 3:05pm
SEP 23 1996

Deborah Six
REGISTER OF DEEDS

Register of Deeds Stamp & File Number

4. Lot No. _____, Recorded Plat _____
5. Private Claims _____

I, John C. Schulke, in a field survey on Dec. 1st, 1995, do hereby certify that under requirements of P.A. 74, Michigan P.A. of 1970, the corner points mentioned in lines 1 and 2 above were in conformance with regulations and rules therefore as required in the current manual of survey instructions of the United States Department of the Interior, Bureau of Land Management or by a decree of a Court of Law and/or that the corner points mentioned in lines 3, 4 and 5 above were in conformance with the rules of the Michigan Board of Professional Surveyors or by a Decree of a Court of Law; established, re-established, monumented, re-monumented, recovered, found as expressed below:

NOTE: Not more than 4 corners, all in the same town and range, may be recorded on this certificate.

A. Description of original monument and accessories and/or subsequent restoration:

Original survey established in 1839 by J. Higbee.

Set a wooden post with the following references:

(1) beech 8" N25°E 25 lks.

(2) beech 6" S31°W 6 lks.

East 7.50 chains Stream 4 lks. flows NW.

In 1905, J. Millard found stake and probable

Beech BT (see Book B, pages 200 & 201 in the

Manistee Register of Deed's Office).

(3) Hemlock stub 22" N72°E 22 lks. Blazes

Ran South and West from this corner.

1986 Sammy Barnett in survey of Section 13 (See Liber 1 of Surveys Page 903), field notes of this survey indicate he apparently set an iron by projecting line South 2640.00 feet from positions he used for K-6 and K-5.

following references:

W. Oak 8" N10°W 23.8 feet

W. Oak 8" N72°E 30.6 feet

"Logging Road West Center Line 7.5' on curve"

A	B	C	D	E	F	G	H	I	J	K	L	M
2	6	5	4	3	2	1						
3												
4	7	8	9	10	11	12						
5												
6	18	17	16	15	14	13						
7												
8	19	20	21	22	23	24						
9												
10	30	29	28	27	26	25						
11												
12	31	32	33	34	35	36						
13												

B. Description of corner evidence found and/or method applied in restoring or reestablishing corner:

Found no evidence in the area of the corner.


Quarter corners to East, South and West are known.

Fence corners to the North 1/4 of a mile and 1/2 mile. Stream to the East found.

Found no evidence of Barnett's stake or BT. No white oaks are growing in the area corner falls. The Barnett position was established using improper procedure and is not utilized in this survey.

Corner K-07 ratified by the Manistee County Peer Group according to the county plan adopted pursuant to P.A. 345 of 1990, as amended, (being the State Survey and Remonument Act, MCL 54.261 et. seq.). Date of Peer Review: SEP 17 1996

Anthony M. Shantz

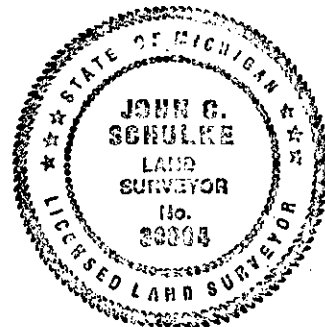

C. Description of monument for corner and accessories established to perpetuate locating the position of the corner:

Proportioned North and South between fence corner at K-6 and corner of K-8.

Projected fence line South from South 1/16th between Sections 13 and 14. Measured East to stream 482.5 ft. (GLO 490 ft.). Location results in following measurements

Fence corner at K-6 2621.11 ft. J-7 2625.21 ft. Note: Found iron under old fence wire East of post 6-28-96 at K-6

K-8 2620.79ft. L-7 2652.33 ft.

Considering this an obliterated restoration of the previously recovered GLO corner. Set 2"X30" pipe monument with a brass cap stamped to identify the corner. The following corner references:

W. Ash 12" S34°W 20.00 ft.

Sug. Maple 16" S66°E 13.82 ft.

Sug. Maple 9" N85°E 56.48 ft.

Sug. Maple 10" N12°W 21.40 ft.

Note: Center of a skid trail is South 11 ft. Monument is about midway down a North slope of hill.

Set Standard Manistee County Monument to restore the corner as a careful and faithful reestablishment of the original corner.

Signed by John C. Schulke

Date June 3, 1996

Surveyor's Michigan License No. 30894