

**LAND CORNER RECORDATION CERTIFICATE**  
**Filing Requirement of Act 74, Mich. P.A. 1970**

For corners in Manistee Located In: \_\_\_\_\_ Corner Code # \_\_\_\_\_  
 (County)

**REGISTER'S OFFICE**  
**MANISTEE COUNTY**

# 97-263 AT 11:30 A.M.  
**JUL 25 1997**

*Penny A. Pepera*  
**REGISTER OF DEEDS**

- |                                      |                           |       |
|--------------------------------------|---------------------------|-------|
| 1. Public Land Survey                | T <u>24N</u> R <u>16W</u> | K-10  |
|                                      | T _____ R _____           | _____ |
|                                      | T _____ R _____           | _____ |
|                                      | T _____ R _____           | _____ |
| 2. Property Controlling in Section   | S _____ T _____ R _____   | _____ |
|                                      | S _____ T _____ R _____   | _____ |
| 3. Miscellaneous Property in Section | S _____ T _____ R _____   | _____ |
|                                      | S _____ T _____ R _____   | _____ |

Register of Deeds Stamp & File Number

4. Lot No. \_\_\_\_\_, Recorded Plat \_\_\_\_\_  
 5. Private Claims \_\_\_\_\_

A	B	C	D	E	F	G	H	I	J	K	L	M
2	6	5	4	3	2	1						
3												
4	7	8	9	10	11	12						
5												
6	18	17	16	15	14	13						
7												
8	19	20	21	22	23	24						
9												
10	30	29	28	27	26	25						
11												
12	31	32	33	34	35	36						
13												

I, John C. Schulke, in a field survey on June 17th, 1997, do hereby certify that under requirements of P.A. 74, Michigan P.A. of 1970, the corner points mentioned in lines 1 and 2 above were in conformance with regulations and rules therefore as required in the current manual of survey instructions of the United States Department of the Interior, Bureau of Land Management or by a decree of a Court of Law and/or that the corner points mentioned in lines 3, 4 and 5 above were in conformance with the rules of the Michigan Board of Professional Surveyors or by a Decree of a Court of Law; established, re-established, monumented, re-monumented, recovered, found as expressed below:

**NOTE: Not more than 4 corners, all in the same town and range, may be recorded on this certificate.**


**A. Description of original monument and accessories and/or subsequent restoration:**

K-10, East Quarter Corner of Section 26, T24N, R16W.  
 1839 James Highbee US Deputy Surveyor set wood post.  
 Beech 12" S13°W 30 links (1)  
 Beech 10" N21°E 26 links (2)

County Surveyor's Book A Page 312 states "established in North-South Road at intersection of road running East. Notes Calls for a gas pipe. Data indicates single proportional measurement. No references listed.

**B. Description of corner evidence found and/or method applied in restoring or reestablishing corner:**

K-10, East Quarter Corner of Section 26, T24N, R16W.  
 Found iron pin 6" below surface of Erdman Road. Directly below iron pin 18" under road found well point with stone on Southeast side. This location is in center line of Erdman Road and 4.5' North of center line of Norconk Road. GLO BTs are gone.

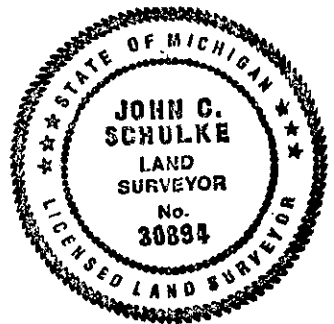

**SURVEYOR**  
**REMONUMENTATION**  
**OCT 14 1997**  
**COMMISSION**

**C. Description of monument for corner and accessories established to perpetuate locating the position of the corner:**

K-10, East Quarter Corner of Section 26, T24N, R16W.  
 Accepted the recovered location of the well point as the best available evidence of the position of the original corner. Set standard Manistee County Monument stamped to identify the corner over well point and in monument box.

New References:  
 Aspen 18" N87°W 32.03 feet (3) Red Pine 6" N51°E 88.57 feet (6)  
 Red Pine 4" S32°E 91.27 feet (4) Red Pine 7" S47°E 66.12 feet (7)  
 Telephone Box S32°E 55.57 feet (5) Stop Sign N73°E 45.05 feet (8)

Corner K-10 ratified by the Manistee County Peer Group according to the county plan adopted pursuant to P.A. 345 of 1990, as amended, (being the State Survey and Remonument Act, MCL 54.261 et. seq.). Date of Peer Review: \_\_\_\_\_

Signed by John C. Schulke Date July 10th, 1997

Surveyor's Michigan License No. 30894