

1993

LAND CORNER RECORDATION CERTIFICATE  
Filing Requirement of Act 74, Mich. P.A. 1970

COMMISSION

For corners in  
Manistee  
(County)

Located In: Corner Code #

1. Public Land Survey	T <u>24N</u> R <u>16W</u>	<u>L-3</u>
	T _____ R _____	_____
	T _____ R _____	_____
	T _____ R _____	_____
2. Property Controlling in Section	S _____ T _____ R _____	_____
	S _____ T _____ R _____	_____
3. Miscellaneous Property in Sec.	S _____ T _____ R _____	_____
	S _____ T _____ R _____	_____

REGISTER'S OFFICE  
MANISTEE COUNTY  
# 93-637 at 9:57 A.M.  
NOV 3 1993  
*Penny A. Peper*  
REGISTER OF DEEDS

Register of Deeds Stamp & File Number

4. Lot No. \_\_\_\_\_, Recorded Plat \_\_\_\_\_  
5. Private Claims \_\_\_\_\_

	A	B	C	D	E	F	G	H	I	J	K	L	M
2	6	5	4	3	2	1							
3													
4	7	8	9	10	11	12							
5													
6	18	17	16	15	14	13							
7													
8	19	20	21	22	23	24							
9													
10	30	29	28	27	26	25							
11													
12	31	32	33	34	35	36							
13													

I, Bruce J. Jenema, in a field survey on October 12, 1993, do hereby certify that under requirements of P.A. 74, Michigan P.A. of 1970, the corner points mentioned in lines 1 and 2 above were in conformance with regulations and rules therefore as required in the current manual of survey instructions of the United States Department of the Interior, Bureau of Land Management or by a decree of a Court of Law and/or that the corner points mentioned in lines 3, 4 and 5 above were in conformance with the rules of the Michigan Board of Land Surveyors or by a Decree of a Court of Law; established, re-established, monumented, re-monumented, recovered, found as expressed below:


NOTE: Not more than 4 corners, all in the same town and range, may be recorded on this certificate.

A. Description of original monument and accessories and/or subsequent restoration:

L-3 One-quarter corner between 1 & 12 40.01 Established by the General Land Office survey by John Brink Set post witness by: 1897  
Hemlock 22" N65°W 30 Links  
Beech 12" S21°E 28 Links  
May 1901 J.H. Mallard, Book A, page 300, Established and witness by:  
Beech 15" S70°W 73 links and Beech 10" N44°E 58 links

B. Description of corner evidence found and/or method applied in restoring or reestablishing corner:

L-3 Found 3/4"x36" Galv. pipe Established by Gourdie-Fraser & Associates, at the N-S & W Old fence lines and Witness by:  
West 23.38' clump of Ash  
N04°W 44.92 12" Maple  
N35°E 10.21' 8" Iron Wood

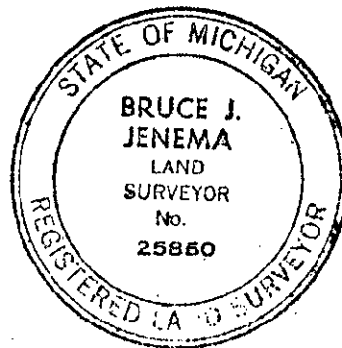

C. Description of monument for corner and accessories established to perpetuate locating the position of the corner:

L-3 South one-quarter of Section 1  
Set 2"x30" Stainless Steel Pipe with Brass cap over 3/4"x36" Galv. Pipe flush with the ground and Witness By:  
8" Ironwood N35°E 10.21' Set 60-D spike  
14" Beech S78°E 65.90' Set 60-D spike  
12" Maple S34°E 27.85' Set 60-D spike  
Triple 10" Ash N78°W 23.85 Set 60-D spike

Corner L-03 ratified by the Manistee County Peer Group pursuant to P.A. 123 of 1915, as amended by P.A. 345 of 1990, as amended. Date of Peer Review: OCTOBER 19, 1993

Signed by Bruce J. Jenema Date Oct. 14, 1993  
Surveyor's Michigan License No. 25850