


LAND CORNER RECORDATION CERTIFICATE
Filing Requirement of Act 74, Mich. P.A. 1970

For corners in Manistee Located In: _____ Corner Code # _____
(County)

1. Public Land Survey T 24N R 16W L-11
 T _____ R _____
 T _____ R _____
 T _____ R _____
2. Property Controlling S _____ T _____ R _____
 in Section S _____ T _____ R _____
3. Miscellaneous S _____ T _____ R _____
 Property in Section S _____ T _____ R _____
4. Lot No. _____, Recorded Plat _____
5. Private Claims _____

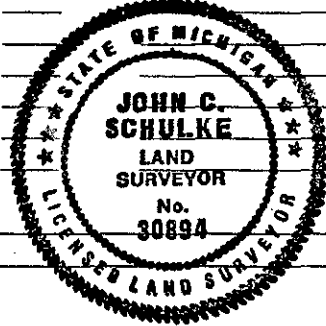

REGISTER'S OFFICE
MANISTEE COUNTY

#97-312 AT 9 27 A.M.
AUG 21 1997

Penny A. Reese
 REGISTER OF DEEDS

Register of Deeds Stamp & File Number

	A	B	C	D	E	F	G	H	I	J	K	L	M
2	6		5		4		3		2		1		
3													
4	7		8		9		10		11		12		
5													
6	18		17		16		15		14		13		
7													
8	19		20		21		22		23		24		
9													
10	30		29		28		27		26		25		
11													
12	31		32		33		34		35		36		
13													

I, John C. Schulke, in a field survey on August 1st, 19 97, do hereby certify that under requirements of P.A. 74, Michigan P.A. of 1970, the corner points mentioned in lines 1 and 2 above were in conformance with regulations and rules therefore as required in the current manual of survey instructions of the United States Department of the Interior, Bureau of Land Management or by a decree of a Court of Law and/or that the corner points mentioned in lines 3, 4 and 5 above were in conformance with the rules of the Michigan Board of Professional Surveyors or by a Decree of a Court of Law; established, re-established, monumented, re-monumented, recovered, found as expressed below:

NOTE: Not more than 4 corners, all in the same town and range, may be recorded on this certificate.

A. Description of original monument and accessories and/or subsequent restoration:

L-11, South Quarter Corner of Section 25, T24N, R16W.
 1839 James Highbee US Deputy Surveyor set wood post.
 References: Sugar 18" S22°W 10 links (1)
 Beech 12" N24°E 30 links (2)
 Book A, Page 312, Manistee County Surveyor's Record.
 Measurements indicate corner was restored on line between K-11 and M-11 by proportional measurement.
 No monument given. A note in remarks column states "1 ft. W. of fence corner".

SURVEY &
 REMONUMENTATION

B. Description of corner evidence found and/or method applied in restoring or reestablishing corner:

L-11, South Quarter Corner of Section 25, T24N, R16W.
 Found 1 1/4" iron pipe flush with ground. Looked for but found no trees used as references or any other evidence of recent surveys or GLO bearing trees. Dale Capman long time farm owner along North side of Section 36 had no knowledge of this pipe but thought it may have been there before he purchased property. In my opinion the pipe could have been placed there at the time of the "Book A Survey." My measurements place the prorated location N54°E a distance of 0.27 feet using existing monuments at K-11 and M-11.

DEC 29 1996

COMMISSION

Found remains of a fence corner post N87°E a distance of 52.7 feet. Down fences run East, West and South from corner post. Fence to South is not a boundary line fence, in my opinion.

C. Description of monument for corner and accessories established to perpetuate locating the position of the corner:

L-11, South Quarter Corner of Section 25, T24N, R16W.
 Based on evidence described above I accepted the recovered location of the 1 1/4" iron pipe as the best available evidence of the position of the original corner.

Set standard Manistee County Monument stamped to identify the corner.
 References: Sugar maple 7" S55°E 59.87 feet (3) Corner 2-11 ratified by the Manistee County Peer Group
 Pin cherry (triple) 10" S14°W 57.00 feet (4) according to the county plan adopted pursuant to P.A. 345 of 1981,
 Pin cherry 9" N48°W 43.89 feet (5) as amended, (being the State Survey and Remonument Act, MCL 54.261
 Pin cherry 12" N74°E 39.01 feet (6) at. seg.). Date of Peer Review: Aug 5, 1997
 Red pine 1" N40°W 32.3 feet (7)

Signed by John C. Schulke
 Surveyor's Michigan License No. 30894

Date August 4th, 1997