

1993

LAND CORNER RECORDATION CERTIFICATE
Filing Requirement of Act 74, Mich. P.A. 1970

For corners in

Manistee

(County)

Located In:

Corner Code: #/

- 1. Public Land Survey T 24N R 16W
T _____ R _____
T 24N R 15W
T _____ R _____
- 2. Property Controlling in Section S _____ T _____ R _____
S _____ T _____ R _____
- 3. Miscellaneous Property in Sec. S _____ T _____ R _____
S _____ T _____ R _____

M-1 ✓

A-1

REGISTER'S OFFICE
MANISTEE COUNTY

93-633 AT 9:45 A.M.

NOV 3 1993

Remond A. Peper
REGISTER OF DEEDS

Register of Deeds Stamp & File Number

- 4. Lot No. _____, Recorded Plat _____
- 5. Private Claims _____

	A	B	C	D	E	F	G	H	I	J	K	L	M
2	6	5	4	3	2	1							
3													
4	7	6	5	4	3	2	1						
5													
6	8	7	6	5	4	3	2	1					
7													
8	9	8	7	6	5	4	3	2	1				
9													
10	10	9	8	7	6	5	4	3	2	1			
11													
12	11	10	9	8	7	6	5	4	3	2	1		
13													

I, Bruce J. Jenema, in a field survey on Sept. 22, 1993

do hereby certify that under requirements of P.A. 74, Michigan P.A. of 1970, the corner points mentioned in lines 1 and 2 above were in conformance with regulations and rules therefore as required in the current manual of survey instructions of the United States Department of the Interior, Bureau of Land Management or by a decree of a Court of Law and/or that the corner points mentioned in lines 3, 4 and 5 above were in conformance with the rules of the Michigan Board of Land Surveyors or by a Decree of a Court of Law; established, re-established, monumented, re-monumented, recovered, found as expressed below:

NOTE: Not more than 4 corners, all in the same town and range, may be recorded on this certificate.

A. Description of original monument and accessories and/or subsequent restoration:

M-1 Northeast corner of Section 1, originally established by the General Land office survey by John Brink 11-4-1836
Set post witness by Beech 11" S77°W 38 links and Beech 16" N71°W 38 links. In 1894 this corner was Re-established by J.H. Mallard by testimony of S.S. Fierch 33' South of Fence corner and witness by 8" Maple S29°W 66'

B. Description of corner evidence found and/or method applied in restoring or reestablishing corner:

M-1 1" Galv. Angle Iron found by Gourdie-Fraser and Associates 2-12-88 and Witness by
16" Maple S55°W 32.85'
12&8" Maple West 40.73'
10" Basswood N45°E 33.43'
14" Maple S48°E 31.85'

Found 1" Galv. Angle iron 4" long, 12" below the surface and excavated this site 4' deep and 2' diameter, did not find any evidence of corner. However we noted remains of Maple stump S29°W 66' as possible Mallard witness

Corner M-1 ratified by the Manistee County Peer Group pursuant to P.A. 123 of 1915, as amended by P.A. 345 of 1990, as amended. Date of Peer Review: NOV 3 1993

C. Description of monument for corner and accessories established to perpetuate locating the position of the corner:


M-1 Northeast corner of Section 1, Common to Sections 6, T24N, R15W and Sections 36, T25N, R16W and Section 31, T25N, R15W
2"x30' Stainless Steel pipe with brass cap 12" below surface of a sand trail road and centerline intersection of a gravel road South & East.
S36°W 36" Maple 43.58', S68°E 12" Elm 54.91', N36°W 8" Maple 72.86', S55°W 16" Maple 32.85' (GFA Witness), N90°W 12"&8" Maple 40.73' (GFA Wit.)

Signed by

Bruce J. Jenema

Surveyor's Michigan License No.

25850

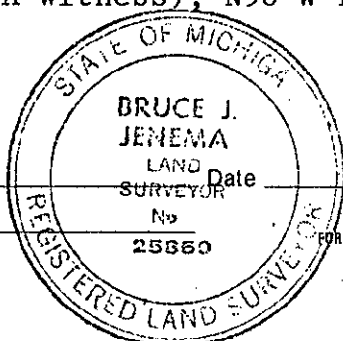

Date Sept. 29, 1993