

1993

LAND CORNER RECORDATION CERTIFICATE
Filing Requirement of Act 74, Mich. P.A. 1970

For corners in
Manistee
(County)

Located In: Corner Code #

- | | | |
|------------------------------------|---------------------------|--------------|
| 1. Public Land Survey | T <u>24N</u> R <u>16W</u> | <u>M-3</u> ✓ |
| | T _____ R _____ | _____ |
| | T <u>24N</u> R <u>15W</u> | <u>A-3</u> |
| | T _____ R _____ | _____ |
| 2. Property Controlling in Section | S _____ T _____ R _____ | _____ |
| | S _____ T _____ R _____ | _____ |
| 3. Miscellaneous Property in Sec: | S _____ T _____ R _____ | _____ |
| | S _____ T _____ R _____ | _____ |

COMMISSION
REGISTER'S OFFICE
MANISTEE COUNTY
93-634 at 9:45 A.M.
NOV 3 1993
Randy A. Rogers
REGISTER OF DEEDS

Register of Deeds Stamp & File Number

4. Lot No. _____, Recorded Plat _____
5. Private Claims _____

I, Bruce J. Jenema in a field survey on Sept. 22, 1993, do hereby certify that under requirements of P.A. 74, Michigan P.A. of 1970, the corner points mentioned in lines 1 and 2 above were in conformance with regulations and rules therefore as required in the current manual of survey instructions of the United States Department of the Interior, Bureau of Land Management or by a decree of a Court of Law and/or that the corner points mentioned in lines 3, 4 and 5 above were in conformance with the rules of the Michigan Board of Land Surveyors or by a Decree of a Court of Law; established, re-established, monumented, re-monumented, recovered, found as expressed below:

A	B	C	D	E	F	G	H	I	J	K	L	A
2	6	5	4	3	2	1						
3												
4	7	8	9	10	11	12						
5												
6	18	17	16	15	14	13						
7												
8	19	20	21	22	23	24						
9												
10	30	29	28	27	26	25						
11												
12	31	32	33	34	35	36						
13												

NOTE: Not more than 4 corners, all in the same town and range, may be recorded on this certificate.

A. Description of original monument and accessories and/or subsequent restoration:

M-3 Southeast corner of Section 2, originally established by the General Land office survey by John Brink 11-4-1836
Set Post Section 1 & 12 Witness by
Beech 8" N80°W 10 links, Beech 11" S47 1/2°W 18 links
J.H. Mallard 1901 Found Stone at corner of Road, Government corner by
Testomony of L.C. Long Witness by Suger 16" S55°E 89 links, Book B, page 56. Also noted page 287, Book A, Found Stone for a survey in Section 7, T24N, R16W,


B. Description of corner evidence found and/or method applied in restoring or reestablishing corner:

M-3 Found 10" square lime stone buried 3' deep. We located this point by measurement of 20.01 ch (1320.66') from the N 1/16 corner between Sections 12 & 7 of T26N, R16W, which is an iron bolt and noted as an iron bolt, Witness by
10" Beech N87°E 51 1/2 links (Found this witness) and a
10" Beech N58°E 76 links

Corner M-03 ratified by the Manistee County Peer Group pursuant to P.A. 123 of 1915, as amended by P.A. 345 of 1990, as amended. Date of Peer Review: APPROVED OCT - 4 1993

C. Description of monument for corner and accessories established to perpetuate locating the position of the corner:

M-3 Southeast corner of Section 1
2"x30" Staninless steel pipe with brass cap
12" below the surface witness by
Electric pole N83°W 50.16'
8" Ash S65°E 91.68'
Electric pole S89°E 167.50'
East NE corner of House S65°W 139.65'
1" Iron bold South 1320.26'

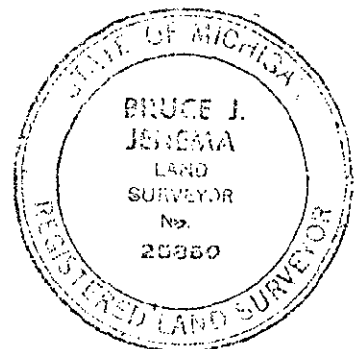

Signed by Bruce J. Jenema
Surveyor's Michigan License No. 25850

Date Sept. 28, 1993