

1993

LAND CORNER RECORDATION CERTIFICATE  
 Filing Requirement of Act 74, Mich. P.A. 1970

COMMISSION

For corners in  
Manistee  
(County)

Located In:

Corner Code #1

- |                                    |                           |              |
|------------------------------------|---------------------------|--------------|
| 1. Public Land Survey              | T <u>24N</u> R <u>16W</u> | <u>M-7</u> ✓ |
|                                    | T _____ R _____           |              |
|                                    | T <u>24N</u> R <u>15W</u> | <u>A-7</u>   |
|                                    | T _____ R _____           |              |
| 2. Property Controlling in Section | S _____ T _____ R _____   |              |
|                                    | S _____ T _____ R _____   |              |
| 3. Miscellaneous Property in Sec.  | S _____ T _____ R _____   |              |
|                                    | S _____ T _____ R _____   |              |

REGISTER'S OFFICE  
 MANISTEE COUNTY

#93-636 at 9:55 A.M.

NOV 3 1993

*Rennay A. Pepera*  
 REGISTER OF DEEDS

Register of Deeds Stamp & File Number

4. Lot No. \_\_\_\_\_, Recorded Plat \_\_\_\_\_  
 5. Private Claims \_\_\_\_\_

	A	B	C	D	E	F	G	H	I	J	K	L	M
2	6	5	4	3	2	1							
3													
4	7	8	9	10	11	12							
5													
6	18	17	16	15	14	13							
7													
8	19	20	21	22	23	24							
9													
10	30	29	28	27	26	25							
11													
12	31	32	33	34	35	36							
13													

I, Bruce J. Jenema, in a field survey on October 7, 1993, do hereby certify that under requirements of P.A. 74, Michigan P.A. of 1970, the corner points mentioned in lines 1 and 2 above were in conformance with regulations and rules therefore as required in the current manual of survey instructions of the United States Department of the Interior, Bureau of Land Management or by a decree of a Court of Law and/or that the corner points mentioned in lines 3, 4 and 5 above were in conformance with the rules of the Michigan Board of Land Surveyors or by a Decree of a Court of Law; established, re-established, monumented, re-monumented, recovered, found as expressed below:


NOTE: Not more than 4 corners, all in the same town and range, may be recorded on this certificate.

A. Description of original monument and accessories and/or subsequent restoration:

M-7 The corner common to Section 13 & 24, originally established by the General Land Office Survey by John Brink 11-4-1836 Set post witness by Lynn 12" S12½W 45 Links and Sugar 11" N55W 44 links.  
 J.H. Mallard Co. surveyor Notes Book A page 306, Dec. 2, 1987, Bearing trees down and shows a distance of 2690.16 ft. to the S 1/4 corner of Section 13, we measured 2656.61 ft.

B. Description of corner evidence found and/or method applied in restoring or reestablishing corner:

M-7 Found 1/2" Iron R.L.S. ID. 17615-19305-24624.  
 Set at the intersections of Old Fence lines N-S-E & W, by Clinton Cole RLS 17615 May 19, 1978 & Witness by 28" Beech S31°E 38.92 ft., 14" Maple S80°E 38.43 ft., 18" Maple N18°E 50.43 ft.,  
 Accepted a best evidence of original corner

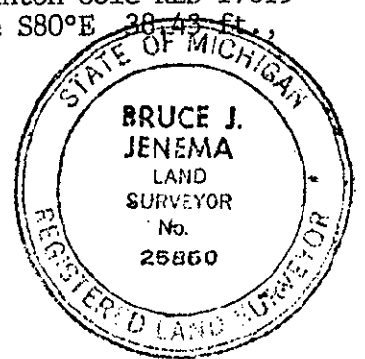

C. Description of monument for corner and accessories established to perpetuate locating the position of the corner:

M-7 Southeast corner of Section 13  
 Set 2"x30" Stainless Steel pipe with Brass Cap flush with the surface of the ground, replaces 1/2" iron with RLS cap and Witness by 20" Maple N20°E 50.58' set 60-D spike  
 36" Maple N66°E 16.40' Set 60-D spike  
 18" Maple S87°E 38.50' Set 60-D spike  
 28" Beech S31°E 38.92' Found #16 nail  
 8" Ash S79°W 25.76' Set 60-D spike

Peer Review: M-07 reviewed by the Peer Group pursuant to P.A. 123 of 1975, as amended by P.A. 345 of 1990, as amended. Date of Peer Review: \_\_\_\_\_

APPROVED NOV 1 1993

Signed by Bruce J. Jenema  
 Surveyor's Michigan License No. 25850

Date Oct. 14, 1993