

**LAND CORNER RECORDATION CERTIFICATE**  
**Filing Requirement of Act 74, Mich. P.A. 1970**

For corners in

<u>MASON</u>	Located In:	Corner Code #
(County)		
1. Public Land Survey	T <u>17N</u> R <u>17W</u>	<u>L-10</u>
	T _____ R _____	_____
	T _____ R _____	_____
	T _____ R _____	_____
2. Property Controlling in Section	S <u>25</u> T _____ R _____	<u>8</u>
	S _____ T _____ R _____	_____
3. Miscellaneous Property in Sec.	S _____ T _____ R _____	_____
	S _____ T _____ R _____	_____

Register of Deeds Stamp & File Number

4. Lot No. \_\_\_\_\_, Recorded Plat \_\_\_\_\_  
 5. Private Claims \_\_\_\_\_

I, C.F. ROSE, in a field survey on AUGUST 17, 19 89, do hereby certify that under requirements of P.A. 74, Michigan P.A. of 1970, the corner points mentioned in lines 1 and 2 above were in conformance with regulations and rules therefore as required in the current manual of survey instructions of the United States Department of the Interior, Bureau of Land Management or by a decree of a Court of Law and/or that the corner points mentioned in lines 3, 4 and 5 above were in conformance with the rules of the Michigan Board of Land Surveyors or by a Decree of a Court of Law, established, re-established, monumented, re-monumented, recovered, found as expressed below:

	A	B	C	D	E	F	G	H	I	J	K	L	M
2	6		5		4		3		2		1		
3													
4	7		8		9		10		11		12		
5													
6	18		17		16		15		14		13		
7													
8	19		20		21		22		23		24		
9													
10	30		29		28		27		26		25		
11													
12	31		32		33		34		35		36		
13													

**NOTE: Not more than 4 corners, all in the same town and range, may be recorded on this certificate.**

A. Description of original monument and accessories and/or subsequent restoration:


L-10	L-10	8	8
------	------	---	---

B. Description of corner evidence found and/or method applied in restoring or reestablishing corner:

L-10	L-10	8	8
ACCEPTED OCCUPIED CTR OF SEC 25. OLD FN'S. N-E-W, SOME CED. POSTS STILL STANDING. OLD COR POST DOWN, BUT ROCKS ETC AT POSTION OF OLD POST. THIS OCCUPANCY APPEARS TO BE A DIRECT RESULT OF SURVEY OF S-25 (AND SEC. SUB'N) BY COUNTY SURVEYOR, R.D. TOWNS, DATED SEPT. 1904 & RECORDED IN OLD CO. SUR. RECORDS IN LIBER 4, PG. 136 & LIBER 2, PG 117.	CONT. CALC. CTR SEC 25 PER STRAIGHT LINE INTER OF 1/4 LINES WOULD BE S55 56'E. 6.99'.	ACCEPTED OCCUPIED POSITION FOR W 1/8 COR ON E-W 1/4 LINE (OLD FN'S E & S) AND APPROX CTR OF GRAVEL ROADS TO N & W. THIS OCCUPANCY APPEAR'S TO BE A DIRECT REBULT OF SUR OF S-25 (AND SEC SUBN) BY CO SURVEYOR, R.D. TOWNS, DATED SEPT 1904 & RECORDED IN OLD CO SUR RECORDS IN LIBER 4, PG 136 & LIBER 2, PG 117. CALC. SP 1/8 COR (PER INTER. OF STRAIGHT 1/4 LINES)	CONT. WOULD BE N76°32'E. 4.0'.

C. Description of monument for corner and accessories established to perpetuate locating the position of the corner:

L-10	L-10	8	8
DROVE 5/8"x 34" REROD W/LS CAP. & SET CED POST W/LOC TAG.		DROVE 5/8"x 34" REROD W/LS CAP.	
9"B. CHERRY N02°W 94.60'		32"R. OAK N30°E 33.68'	
11"B. CHERRY DUE E 98.14'		39"R. OAK N70°E 67.55'	
3-4'TALL ELMS S65°E 3.2'		4"R. OAK S10°E 21.60'	
		NAILED DNR LOC TAG ON COR CED FN POST DUE S 1.5'	

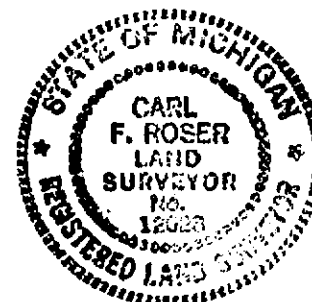

Signed by Carl F. Roser 02/23/91

Date \_\_\_\_\_

Surveyor's Michigan License No. 12028