LAND CORNER RECORDATION CERTIFICATE

Filing Requirement of Act 74, Mich. P.A. 1970

For corners in
MASON
(County)

	Located In:	Corner Code #/#
1. Public Land Survey	T 17N R 17W	K-9
	T ___ R ___	L-9
	T ___ R ___	M-9
	T ___ R ___	
2. Property Controlling	S ___ T ___ R ___	
in Section	S ___ T ___ R ___	
3. Miscellaneous	S ___ T ___ R ___	
Property in Sec.	S ___ T ___ R ___	

Register of Deeds Stamp & File Number

4. Lot No. _____ , Recorded Plat _____
5. Private Claims _____

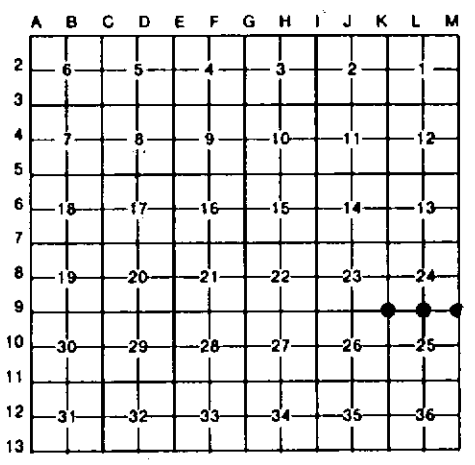

I, C.F.ROSER, in a field survey on AUGUST 21, 19 89, do hereby certify that under requirements of P.A. 74, Michigan P.A. of 1970, the corner points mentioned in lines 1 and 2 above were in conformance with regulations and rules therefore as required in the current manual of survey instructions of the United States Department of the Interior, Bureau of Land Management or by a decree of a Court of Law and/or that the corner points mentioned in lines 3, 4 and 5 above were in conformance with the rules of the Michigan Board of Land Surveyors or by a Decree of a Court of Law; established, re-established, monumented, re-monumented, recovered, found as expressed below:

NOTE: Not more than 4 corners, all in the same town and range, may be recorded on this certificate.

A. Description of original monument and accessories and/or subsequent restoration:

K-9

L-9

M-9

B. Description of corner evidence found and/or method applied in restoring or reestablishing corner:

K-9
RESTABLISHED NW COR OF SEC 25 PER CONSUMERS POWER CO 1968 SURVEY IN SEC'S 24 & 23 (CO.PO.CO. SET 1" PIPE AT FENCE INTERSECTION). FN COR NOW DOWN & DESTROYED. CTR OF E-W DITCH LOOKING EASTWARD, IS 9'± SOUTH. CTR N-S DITCH IS EAST, 15'±.

L-9
FD PIPE FOR N1/4 COR SEC 25 AS ESTABLISHED BY CONSUMERS POWER CO. IN 1968 SURVEY OF SEC 24 (CO.PO.CO. SET 1" PIPE AT FENCE INTERSECTION). PIPE IS IN LINE W/OLD FN REMAINS N-S-E-W.

M-9
FD 1 1/2" PIPE FOR NE COR SEC 25. COR IS IN LINE WITH OLD FN. WEST AND FENCE REMAINS EAST. AND IS 1' WEST OF CTR N-S B.TOP RD. PIPE FITS CONS. POWER CO. 1968 SURVEY OF SEC 24.

C. Description of monument for corner and accessories established to perpetuate locating the position of the corner:

K-9
SET DNR MON & CEDAR POST.

3"ASH	N05°E	31.10'
6"MAPLE(IN CLP)	N40°E	15.58'
6"ASH	S75°E	12.58'
10"B.CHERRY	S60°E	6.60'

L-9
FD 3/4" PIPE. ADDED CED POST W/LDC TAG.

2"ELM	S08°E	10.9'
9"BASSWOOD	S03°E	146.46'
5"ASPEN	S45°W	42.40'
4"APPLE IN CLP 3	DUE W	60.23'

M-9
FD 1 1/2" PIPE.

POWER POLE	N W	76.44'
FN POST	DUE W	33.76'

NO OTHER WIT CLOSE BY.

STATE OF MICHIGAN
CARL F. ROSER
LAND SURVEYOR
No. 12020
REGISTERED LAND SURVEYOR

Signed by Carl F. Roser 02/23/91 Date _____

Surveyor's Michigan License No. 12020

FORM APPROVED BY MICHIGAN STATE BOARD OF LAND SURVEYORS, JAN. 28, 1971
REVISED MAY 14, 1975
REVISED JAN., 1983