

**SURVEY &
REMONUMENTATION**


MAR 08 1994

COMMISSION

LAND CORNER RECORDATION CERTIFICATE
Filing Requirement of Act 74, Mich. P.A. 1970

For corners in

Mason (County) Located In: Corner Code #
 1. Public Land Survey T 17N R 15W A-5
 T _____ R _____
 T _____ R _____
 T _____ R _____
 2. Property Controlling S _____ T _____ R _____
 in Section S _____ T _____ R _____
 3. Miscellaneous S _____ T _____ R _____
 Property in Sec. S _____ T _____ R _____

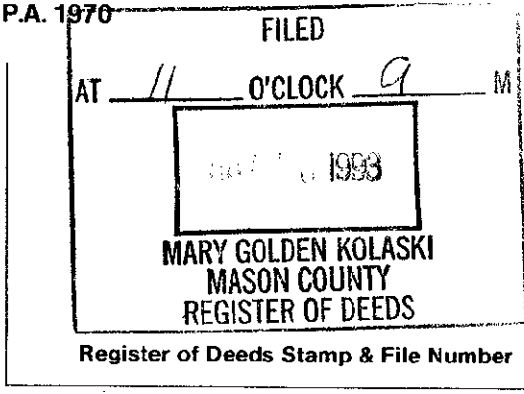

4. Lot No. _____, Recorded Plat _____
 5. Private Claims _____

	A	B	C	D	E	F	G	H	I	J	K	L	M
2	6		5		4		3		2		1		
3													
4	7		8		9		10		11		12		
5													
6	18		17		16		15		14		13		
7													
8	19		20		21		22		23		24		
9													
10	30		29		28		27		26		25		
11													
12	31		32		33		34		35		36		
13													

I, Richard Hays, in a field survey on November 2, 1993, do hereby certify that under requirements of P.A. 74, Michigan P.A. of 1970, the corner points mentioned in lines 1 and 2 above were in conformance with regulations and rules therefore as required in the current manual of survey instructions of the United States Department of the Interior, Bureau of Land Management or by a decree of a Court of Law and/or that the corner points mentioned in lines 3, 4 and 5 above were in conformance with the rules of the Michigan Board of Land Surveyors or by a Decree of a Court of Law; established, re-established, monumented, re-monumented, recovered, found as expressed below:

NOTE: Not more than 4 corners, all in the same town and range, may be recorded on this certificate.

A. Description of original monument and accessories and/or subsequent restoration:

A-5 Section corner common to sections 7, 8 T17N R15W & sections 12&13 T17N R16W
 1838 G.L.O. set post 1970 Robert Griffin
 8" W. Pine S 77° W 24 lks Found 3/4" Iron rod & post
 7" Beech N 48° W 36 lks 1972 Robert Griffin
 1943 Survey R.S. Copeland USFS Replaced 3/4" iron rod w/USFS monume
 Set Iron rod 113 lks S of fence E&W & 8" W Oak N 35° E 15.40
 64 lks W of fence N&S. 8" W Oak S 62° E 36.65
 USFS post East 2 Lks. 11" R Oak N 76° W 16.48
 Post North 1.70
 L.C.R.C. Liber 1 pg 187

B. Description of corner evidence found and/or method applied in restoring or reestablishing corner:

A-5 Section corner common to Sections 7, 8 T17N R15W & sections 12, 13 T17N R16W
 1993 Found USFS monument and witness L.C.R.C. Liber 1 pg 187
 8" W Oak N 35° E 15.40
 8" W Oak N 62° E 36.65
 11" R oak N 76° W 16.48
 Post North 1.7

C. Description of monument for corner and accessories established to perpetuate locating the position of the corner:

A-5 Section corner common to Sections 7, 8 T17N R15W & Sections 12, 13 T17N R16W
 Accepted 5" sq conc monument w/brass cap stamped to identify the corner and is accepted as the best available evidence of the position of the original corner.
 8" W Oak N 35° E 15.40
 8" W Oak S 62° E 36.65
 11" R Oak N 76° W 16.48
 13" W Oak S 21° W 32.81
 4" Sq Pine Post North 1.7



LIBER 3 PAGE 150

Signed by Richard Hays
 Surveyor's Michigan License No. 25847

Date 11/5/93
 Peer Group Reviewed and Approved: [Signature]
 Date: 11-9-93
[Signature]
 Kenneth L. Ross
 Mason County Surveyor