

**SURVEY & REMONUMENTATION**

**SEP 30 1993 LAND CORNER RECORDATION CERTIFICATE**  
**COMMISSION FILING REQUIREMENT OF ACT 74, MICH. P.A.1970**

FOR CORNERS OF--:	LOCATED IN--:	CORNER CODE NUMBER											
1. PUBLIC LAND SURVEY_____ T. _____	17N N. 15W E. S., R. _____ W.	A13	<table border="1"> <tr> <td colspan="2" style="text-align: center;"><b>FILED</b></td> </tr> <tr> <td style="text-align: center;">2</td> <td style="text-align: center;">O'CLOCK</td> </tr> <tr> <td colspan="2" style="text-align: center;">SEP 23 1993</td> </tr> <tr> <td colspan="2" style="text-align: center;">MARY GOLDEN KOLASKI MASON COUNTY REGISTER OF DEEDS</td> </tr> <tr> <td colspan="2" style="text-align: center;">REGISTER OF DEEDS STAMP AND FILING NUMBER</td> </tr>
2. PROPERTY CONTROLLING IN SECTION _____, T. _____	N. _____ E. S., R. _____ W.												
3. MISCELLANEOUS PROPERTY IN SECTION _____, T. _____	N. _____ E. S., R. _____ W.												
4. LOT NO. _____, RECORDED PLAT _____													
5. PRIVATE CLAIMS _____													

I, Patrick R. Leemon do hereby certify that under requirements of P.A. 74, Michigan P.A. of 1970, the corner points mentioned in lines 1 and 2 above (identified with circles on index code diagram - over) were, in a field survey on August 23 1993, established, re-established, monumented, re-monumented, recovered or restored as expressed below and in conformance with regulations and rules therefore as required in the current manual of survey instructions of the United States Department of the Interior, Bureau of Land Management or by a decree of a court of law. Furthermore, that the corner points mentioned in lines 3, 4 and 5 above were, in a field survey on \_\_\_\_\_ 19\_\_\_\_, found, recovered, restored, established or re-established as expressed below and in conformance with the rules of the Michigan State Board of Registration for Land Surveyors or, by a Decree of a Court of law:

A. Description of original monument and accessories and/or subsequent restoration:

**Section corner common to section 31 of T17N R15W, section 36 of T17N R16W, section 6 of T16N R15W and section 1 of T16N R16W.**

1835 survey by Mullett & Brookfield Set Wood Post Maple 9 S35W 35 links Y.Pine 18 N63E 21 links	1940 survey by H.Amouts Monument is an Iron Stake Maple 15 N1/2E 101 links W.Oak 10 S33W 121 links Fence Cor. Post S83W 47 links	1972 survey by Robert A. Griffin Fd. a 3" diam. cast iron pump base replaced w/ a 5" sq.x 60" long conc. monu. w/brass cap. W.Pine Stp. 30 N50W <del>40</del> 52.8' Fence Cor.Post S78W 31.30 feet Tw.W.Oak 9x16 N41W 69.07 feet P.Post 4'x7' North 1.2 feet
1909 survey by C.Landon No Monument mentioned W.Pine 22 N33E 70 links W.Pine 30 N50W 80 links	1980 survey by Dunlap Fd. conc. monu. by Griffin Oak 40 S60E 67.31 feet	

B. Description of corner evidence found and/or method applied in restoring or re-establishing corner:  
 I found the 5" square by 60" long concrete monument w/ brass cap by Griffin destroyed. The following witnesses present in 1972 are now gone: Griffin's P.Post, Fence cor. Post, and Landon's W.Pine 30". The Oak 40" by Dunlap is really a cottonwood. Liber 1 Page 189 by Griffin documents the history of this corner. This monument is accepted as a careful and faithful perpetuation of the position of the original corner.

C. Description of monument for corner and accessories established to perpetuate locating the position of the corner:


**Section corner common to section 31 of T17N R15W, section 36 of T17N R16W, section 6 of T16N R15W and section 1 of T16N R16W.**  
 Monu. Placed the old brass cap in bottom of hole and set a 2"x30" Iron Pipe w/brass cap 4" beneath the surface.

Witnesses:  
 Tw.B.Oak 9x12 S64W 36.16'  
 R.Maple 30 N3W 67.27'  
 R.Pine 10 N24E 93.08'  
 R.Oak 7 N83E 96.33'  
 Fiberglass Post West 25.5'  
 Tw.W.Oak 20x30 N45W 69.07'

The corner is 10 feet East of centerline of the road to the south, 47 feet West of centerline of the curve to the NE, 22 feet West of centerline of a 2-track to the North and S60E 29 feet from a road closure berm.

SIGNED BY Patrick R. Leemon DATE September 9, 1993  
 SURVEYOR'S MICHIGAN REGISTRATION NO. 31595

FOR STATE AND UNITED STATES AGENCIES:  
 SIGNED BY \_\_\_\_\_ DATE \_\_\_\_\_  
 CHIEF OF SURVEY PARTY  
 APPROVED AND SIGNED BY \_\_\_\_\_ DATE \_\_\_\_\_  
 MICHIGAN REGISTERED LAND SURVEYOR

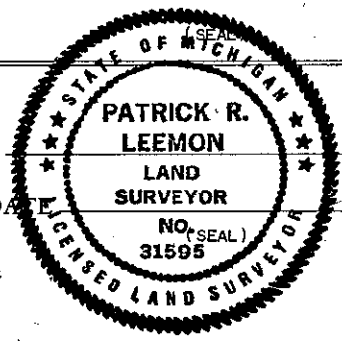

Peer Group Reviewed and Approved  
 Date: 9-16-93  
 Kenneth L. Ross  
 Mason County Surveyor

LIBER **3** PAGE **121**