

**SURVEY & REMONUMENTATION**

**SEP 30 1993 LAND CORNER RECORDATION CERTIFICATE**

**COMMISSION FILING REQUIREMENT OF ACT 74, MICH. P.A.1970**

FOR CORNERS OF-- LOCATED IN-- CORNER CODE NUMBER

17N N. 15W E.  
 1. PUBLIC LAND SURVEY T. S., R. W.

2. PROPERTY CONTROLLING IN SECTION T. N. S., R. E. W.

3. MISCELLANEOUS PROPERTY IN SECTION T. N. S., R. E. W.

4. LOT NO. , RECORDED PLAT

5. PRIVATE CLAIMS

C5

AT 2 O'CLOCK P M

SEP 23 1993

MARY GOLDEN KOLASKI  
 MASON COUNTY  
 REGISTER OF DEEDS

REGISTER OF DEEDS STAMP AND FILING NUMBER

I, Patrick R. Leemon do hereby certify that under requirements of P.A. 74, Michigan P.A. of 1970, the corner points mentioned in lines 1 and 2 above (identified with circles on index code diagram - over) were, in a field survey on August 23 1993, established, re-established, monumented, re-monumented, recovered or restored as expressed below and in conformance with regulations and rules therefore as required in the current manual of survey instructions of the United States Department of the Interior, Bureau of Land Management or by a decree of a court of law. Furthermore, that the corner points mentioned in lines 3, 4 and 5 above were, in a field survey on 19 , found, recovered, restored, established or re-established as expressed below and in conformance with the rules of the Michigan State Board of Registration for Land Surveyors or, by a Decree of a Court of law:

A. Description of original monument and accessories and/or subsequent restoration:

**Section corner common to sections 7, 8, 17 and 18 of T17N R15W**

1838 survey by John Hodgson W.Oak 24" for corner	1939 survey by P. Aman (USFS) Monument is a wood post W.Oak 12 S83-30W 45 links	1972 survey by Robert A. Griffin Fd. wood stake from Brass wits. replaced w/ a 5" sq. x 60" long conc. monu. w/brass cap. P.Post 4"x7" East 1.5 feet R.Oak 12 N20E 32.30 feet W.Oak 8 N45E 51.83 feet W.Oak 6 S61W 38.25 feet Iron Pipe 1/2"x18" N28W 95.32'
1960 survey by G.Blass Monument is a wood stake Iron Pipe 1/2"x18" N28W 95.32 feet Iron Pipe 1/2"x18" N66E 167.04 feet	Undated survey by Mason Co. Road Commission No monument mentioned W.Oak ? S83 1/2W 29.70 feet	

B. Description of corner evidence found and/or method applied in restoring or re-establishing corner:

I found the 5" square by 60" long concrete monument w/ brass cap by Griffin rising 18" above the surface at a fence corner with woven wire fences East and South and 83' south of the centerline of the E-W pavement and 500' East of a gravel road to the south. Liber 1 Page 192 by Griffin documents the history of this corner. The GLO distance to the SW corner shows 5280 feet mile while a 1993 survey by Hays recorded in Liber 430 Page 1090 returned 4998.82 feet. This is extremely short. I did find a 40" W.Oak 302 ft. east and 86 ft. north of Griffin's monu. I didn't accept this tree as the original because although it fit better E&W it would make the 1/2 mile going north 90 ft. short. The use of this position is documented prior to 1939 and occupation indicates this is the accepted position. I therefore accept this monument as the best available evidence of the position of the original corner.

C. Description of monument for corner and accessories established to perpetuate locating the position of the corner:

**Section corner common to sections 7, 8, 17 and 18 of T17N R15W**  
 Monu. 5" sq. by 60" long concrete monu. with 3" brass disk was left in place.  
 Witnesses:  
 R.Oak 18 N19E 32.35'  
 P.Post 4"x7" East 1.32'  
 W.Oak 14 N44E 51.89'  
 W.Oak 11 S58W 38.19'  
 R.Maple 5 N64W 30.94'

Peer Group Reviewed and Approved  
 Date: 9-16-93  
 Kenneth L. Ross  
 Mason County Surveyor


SIGNED BY Patrick R. Leemon DATE September 9, 1993

SURVEYOR'S MICHIGAN REGISTRATION NO. 31595

FOR STATE AND UNITED STATES AGENCIES:

SIGNED BY \_\_\_\_\_ DATE \_\_\_\_\_  
 CHIEF OF SURVEY PARTY

APPROVED AND SIGNED BY \_\_\_\_\_ DATE \_\_\_\_\_  
 MICHIGAN REGISTERED LAND SURVEYOR

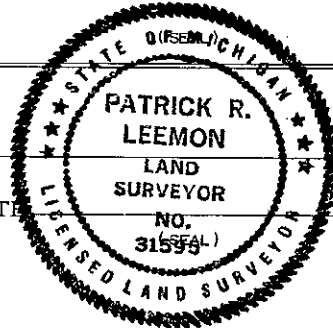

**LIBER 3 PAGE 114**

SURVEYOR'S MICHIGAN REGISTRATION NO. \_\_\_\_\_