

1993

COMMISSION

LAND CORNER RECORDATION CERTIFICATE
Filing Requirement of Act 74, Mich. P.A. 1970

For corners in

Located In: _____ Corner Code # _____


1. Public Land Survey T 17NR 15W E-6
 T _____ R _____
 T _____ R _____
 T _____ R _____

2. Property Controlling S _____ T _____ R _____
 in Section S _____ T _____ R _____

3. Miscellaneous S _____ T _____ R _____
 Property in Sec. S _____ T _____ R _____

4. Lot No. _____, Recorded Plat _____

5. Private Claims _____

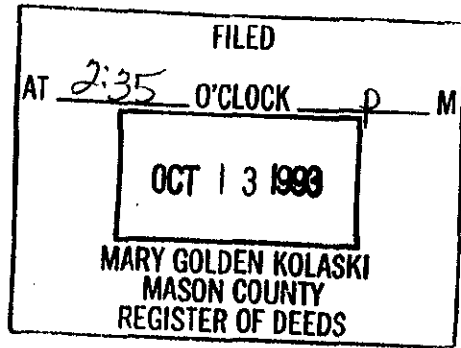

Register of Deeds Stamp & File Number

I, Kenneth L. Ross, in a field survey on SEPTEMBER, 19 93, do hereby certify that under requirements of P.A. 74, Michigan P.A. of 1970, the corner points mentioned in lines 1 and 2 above were in conformance with regulations and rules therefore as required in the current manual of survey instructions of the United States Department of the Interior, Bureau of Land Management or by a decree of a Court of Law and/or that the corner points mentioned in lines 3, 4 and 5 above were in conformance with the rules of the Michigan Board of Land Surveyors or by a Decree of a Court of Law; established, re-established, monumented, re-monumented, recovered, found as expressed below:

NOTE: Not more than 4 corners, all in the same town and range, may be recorded on this certificate.

	A	B	C	D	E	F	G	H	I	J	K	L	M
2	6	5	4	3	2	1							
3													
4	7	8	9	10	11	12							
5													
6	18	17	16	15	14	13							
7													
8	19	20	21	22	23	24							
9													
10	30	29	28	27	26	25							
11													
12	31	32	33	34	35	36							
13													

A. Description of original monument and accessories and/or subsequent restoration:

E-5 Section Corner, Secs. 8, 9, 16 & 17
 1838 John Hodgeson set Post
 12" Hemlock S 37 E 8 lks
 8" Hemlock N 7 W 16 lks

E-6 1/4 Corner, Secs. 16 & 17
 1838 John Hodgeson set Post
 10" Pine for corner
 12" Beech N 65 E 18 lks
 8" Maple S 58 W 36 lks

B. Description of corner evidence found and/or method applied in restoring or reestablishing corner:

E-5 Section Corner, Secs. 8, 9, 16 & 17
 Stephens 1955 Fd & used CCC-Post
 Kraft dist to N 1/4 (1972) = 2629.67
 Griffin 1973 Fd tack hub by Kraft took 2 witness
 2" R. Oak S 53 E 22.83 16" R. Pine S 05 W 34.68
 Ross 1992 Fd Griffin witness, set 1/2" capped Iron
 took 4 new witness & filed Act 132
 6" Oak S 53 E 22.83'
 20" Maple S 43 W 54.61'
 7" Oak N 68 W 86.28'
 14" R. Pine S 05 W 34.68'


E-6 1/4 Corner, Secs. 16 & 17
 Stephens 1971 set cor 1/2 way on line between
 NW & SW cor
 Undated survey by Bonney uses Stephens 1/4 cor
 (E-6) that Ross found to be in error
 Ross 1992 set E-6 1/2 way on line between
 NW & SW cor filed Act 132
 6" R. Oak N 64 E 6.82'
 10" W. Oak S 30 E 23.37'
 30" W. Oak S 88 W 43.98'
 Iron by Bonney N 39 E 25.70'

C. Description of monument for corner and accessories established to perpetuate locating the position of the corner:

E-5 Section Corner, Secs. 8, 9, 16 & 17
 Found 1/2" Iron re-bar set from Griffin's witness,
 replaced with 5/8" X 36" re-bar with 2 1/2" alum.
 cap, and is accepted as the best available
 evidence of the original corner.
 6" W. Oak S 53 E 22.83'
 20" Maple S 43 W 54.61'
 7" W. Oak N 68 W 86.28'
 14" R. Pine S 05 W 34.68'

E-6 1/4 Corner, Secs. 16 & 17
 Found Ross capped Iron set 1/2 way on line between.
 NW & SW cor; found Bonney Iron N 39 E 25.70', did
 not accept position & removed; replaced Ross Iron
 with 5/8" X 36" re-bar with 2 1/2" alum. cap, and
 is accepted as the best available evidence of the
 original corner.
 1 1/2" Iron pipe 1' above surface N 56 E 25.81'
 10" B. Oak N 24 E 45.70'
 30" R. Oak S 88 W 43.92'
 8" B. Oak N 64 E 6.82'
 10" Maple S 30 E 23.37'

Signed by _____
 Surveyor's Michigan License No. 17634

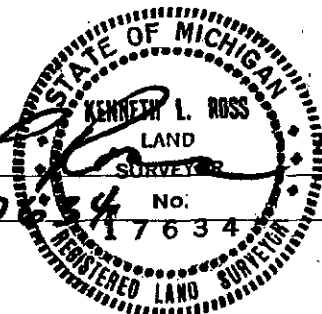

Date: 10-13-93
 and approved
 Kenneth L. Ross
 Mason County Surveyor