


1993

COMMISSION

LAND CORNER RECORDATION CERTIFICATE  
Filing Requirement of Act 74, Mich. P.A. 1970


For corners in

Located In: \_\_\_\_\_ Corner Code: 44

1. Public Land Survey T 17NR 15W E-5 

2. Property Controlling in Section S \_\_\_\_\_ T \_\_\_\_\_ R \_\_\_\_\_

3. Miscellaneous Property In Sec. S \_\_\_\_\_ T \_\_\_\_\_ R \_\_\_\_\_

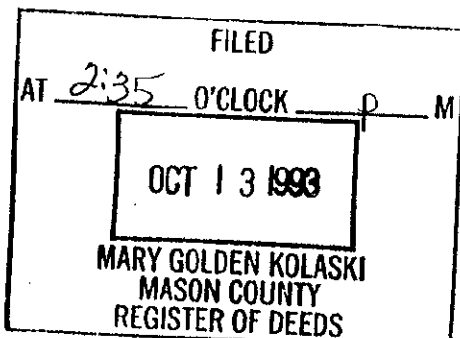

Register of Deeds Stamp & File Number

4. Lot No. \_\_\_\_\_, Recorded Plat \_\_\_\_\_

5. Private Claims \_\_\_\_\_

	A	B	C	D	E	F	G	H	I	J	K	L	M
2	6		5		4		3		2		1		
3													
4	7		8		9		10		11		12		
5													
6	18		17		16		15		14		13		
7													
8	19		20		21		22		23		24		
9													
10	30		29		28		27		26		25		
11													
12	31		32		33		34		35		36		
13													

I, Kenneth L. Ross, in a field survey on SEPTEMBER, 1993, do hereby certify that under requirements of P.A. 74, Michigan P.A. of 1970, the corner points mentioned in lines 1 and 2 above were in conformance with regulations and rules therefore as required in the current manual of survey instructions of the United States Department of the Interior, Bureau of Land Management or by a decree of a Court of Law and/or that the corner points mentioned in lines 3, 4 and 5 above were in conformance with the rules of the Michigan Board of Land Surveyors or by a Decree of a Court of Law; established, re-established, monumented, re-monumented, recovered, found as expressed below:

NOTE: Not more than 4 corners, all in the same town and range, may be recorded on this certificate.

A. Description of original monument and accessories and/or subsequent restoration:

- E-5 Section Corner, Secs. 8, 9, 16 & 17  
1838 John Hodgeson set Post  
12" Hemlock S 37 E 8 lks  
8" Hemlock N 7 W 16 lks
- E-6 1/4 Corner, Secs. 16 & 17  
1838 John Hodgeson set Post  
10" Pine for corner  
12" Beech N 65 E 18 lks  
8" Maple S 58 W 36 lks


B. Description of corner evidence found and/or method applied in restoring or reestablishing corner:

- E-5 Section Corner, Secs. 8, 9, 16 & 17  
Stephens 1955 Fd & used CCC-Post  
Kraft dist to N 1/4 (1972) = 2629.67  
Griffin 1973 Fd tack hub by Kraft took 2 witness  
2" R. Oak S 53 E 22.83 16" R. Pine S 05 W 34.68  
Ross 1992 Fd Griffin witness, set 1/2" capped Iron took 4 new witness & filed Act 132  
6" Oak S 53 E 22.83'  
20" Maple S 43 W 54.61'  
7" Oak N 68 W 86.28'  
14" R. Pine S 05 W 34.68'
- E-6 1/4 Corner, Secs. 16 & 17  
Stephens 1971 set cor 1/2 way on line between NW & SW cor  
Undated survey by Bonney uses Stephens 1/4 cor (E-6) that Ross found to be in error  
Ross 1992 set E-6 1/2 way on line between NW & SW cor filed Act 132  
6" R. Oak N 64 E 6.82'  
10" W. Oak S 30 E 23.37'  
30" W. Oak S 88 W 43.98'  
Iron by Bonney N 39 E 25.70'

C. Description of monument for corner and accessories established to perpetuate locating the position of the corner:

- E-5 Section Corner, Secs. 8, 9, 16 & 17  
Found 1/2" Iron re-bar set from Griffin's witness, replaced with 5/8" X 36" re-bar with 2 1/2" alum. cap, and is accepted as the best available evidence of the original corner.  
6" W. Oak S 53 E 22.83'  
20" Maple S 43 W 54.61'  
7" W. Oak N 68 W 86.28'  
14" R. Pine S 05 W 34.68'
- E-6 1/4 Corner, Secs. 16 & 17  
Found Ross capped Iron set 1/2 way on line between NW & SW cor; found Bonney Iron N 39 E 25.70', did not accept position & removed; replaced Ross Iron with 5/8" X 36" re-bar with 2 1/2" alum. cap, and is accepted as the best available evidence of the original corner.  
1 1/2" Iron pipe 1' above surface N 56 E 25.81'  
10" B. Oak N 24 E 45.70'  
30" R. Oak S 88 W 43.92'  
8" B. Oak N 64 E 6.82'  
10" Maple S 30 E 23.37'

Signed by \_\_\_\_\_  
Surveyor's Michigan License No. 17634

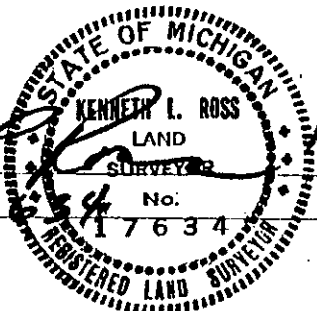

Date: 10-13-93  
and approved  
Kenneth L. Ross  
Mason County Surveyor