

1993

COMMISSION

LAND CORNER RECORDATION CERTIFICATE

Filing Requirement of Act 74, Mich. P.A. 1970

For corners in

MASON (County) Located In: Corner Code #7


1. Public Land Survey T 17NR 15W F-7

2. Property Controlling in Section S T R

3. Miscellaneous Property in Sec. S T R

4. Lot No. , Recorded Plat

5. Private Claims

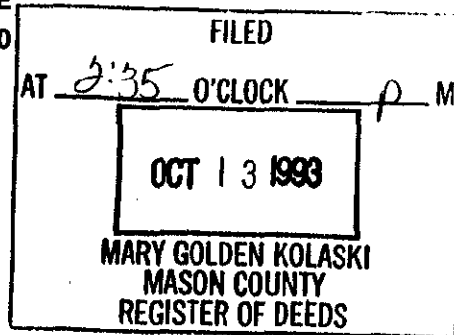

Register of Deeds Stamp & File Number

I, Kenneth L. Ross, in a field survey on OCTOBER, 1993, do hereby certify that under requirements of P.A. 74, Michigan P.A. of 1970, the corner points mentioned in lines 1 and 2 above were in conformance with regulations and rules therefore as required in the current manual of survey instructions of the United States Department of the Interior, Bureau of Land Management or by a decree of a Court of Law and/or that the corner points mentioned in lines 3, 4 and 5 above were in conformance with the rules of the Michigan Board of Land Surveyors or by a Decree of a Court of Law; established, re-established, monumented, re-monumented, recovered, found as expressed below:

	A	B	C	D	E	F	G	H	I	J	K	L	M
2	6		5		4		3		2		1		
3													
4	7		8		9		10		11		12		
5													
6	18		17		16		15		14		13		
7													
8	19		20		21		22		23		24		
9													
10	30		29		28		27		26		25		
11													
12	31		32		33		34		35		36		
13													

NOTE: Not more than 4 corners, all in the same town and range, may be recorded on this certificate.

A. Description of original monument and accessories and/or subsequent restoration:

- E-7 Section corner, Secs. 16, 17, 20, & 21 1838 John Hodgeson set Post 12" Maple S 59 E 17 lks 14" Maple N 76 W 20 lks
- F-7 1/4 corner, Secs. 16 & 21 1838 John Hodgeson set Post 12" Beech N 42 E 30 lks 10" Beech S 61 W 7 lks

B. Description of corner evidence found and/or method applied in restoring or reestablishing corner:


- E-7 Section corner, Secs. 16, 17, 20, & 21 Stephens 1971 set 1" pipe from witness Griffin 1973 set 5" X 60" conc. monument Act 74 recorded Liber 1, Page 244 took 4 witness Tw Maple 6" & 4" N 45 E 27.95' R. Oak 20" S 74 W 41.95' 4" X 7' Pine Post W 1.6' W. Oak 10" N 33 W 76.03' Ross 1992 Fd Griffin USFS conc. monument took 3 new witness filed Act 132 18" W. Oak N 33 W 76.03' 10" Tw. Maple N 45 E 27.95' Cen. 2 Tr. Rd. South 47'
- F-7 1/4 corner, Secs. 16 & 21 Stephens 1971 set 1" pipe from witness Griffin 1973 set 2" X 24" pipe took 3 witness 24" Maple N 42 W 112.55 22" W. Pine S 38 E 87 1/2 lks (OBT) 24" W. Pine N 05 W 25 1/2 lks (OBT) Undated survey by Bonney sets 1/2" re-rod using witness took 3 new witness 30" Maple N 42 W 112.55. 4" Wild Cherry S 30 W 42.10 4" Wild Cherry N 65 E 27.10 Ross 1992 Fd Bonney capped Iron & witness took 4 new witness & filed Act 132 8" W. Oak N 51 W 76.19' 5" W. Oak S 72 W 76.32' 6" Cherry N 65 E 27.08' 24" Maple N 42 W 112.55'

C. Description of monument for corner and accessories established to perpetuate locating the position of the corner:

- E-7 Section corner, Secs. 16, 17, 20, & 21 Found USFS conc. monument 1.3' above surface took 7 witness, and is accepted as the best available evidence of the original corner. Gov't Post West 1.5' 10" Tw. Maple N 45 E 28.06' 18" W. Oak N 33 W 75.96' 8" Cherry S 81 E 25.08' 26" R. Oak S 82 W 41.72' 24" R. Oak N 66 W 68.17' Center line E-W 2 Track South
- F-7 1/4 corner, Secs. 16 & 21 Found 1/2" capped re-bar RLS 12016, replaced with 5/8" X 36" re-bar with 2 1/2" alum. cap, and is accepted as the best available evidence of the original corner. 8" W. Oak N 51 W 76.19' 5" W. Oak S 72 W 76.32' 6" Cherry N 65 E 27.08' 24" Tri Maple N 42 W 112.55'

Signed by [Signature] Date 10-13-93

Surveyor's Michigan License No. 17634

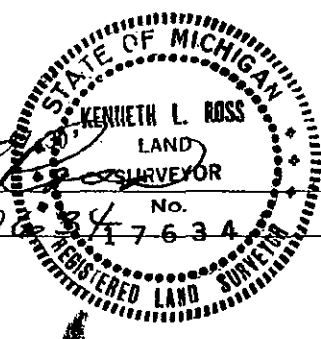

Peer Group Reviewed and Approved  
Date: 10-13-93  
Kenneth L. Ross  
Mason County Surveyor