


1993

COMMISSION

LAND CORNER RECORDATION CERTIFICATE
Filing Requirement of Act 74, Mich. P.A. 1970

For corners in

_____ MASON _____ (County)	Located In:	Corner Code #
1. Public Land Survey	T 17NR 15W	F-5,
	T _____ R _____	_____
	T _____ R _____	_____
	T _____ R _____	_____
2. Property Controlling In Section	S _____ T _____ R _____	_____
	S _____ T _____ R _____	_____
3. Miscellaneous Property In Sec.	S _____ T _____ R _____	_____
	S _____ T _____ R _____	_____

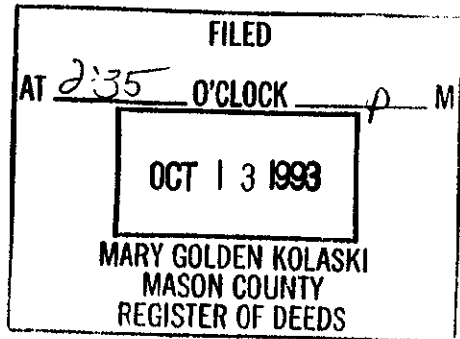

Register of Deeds Stamp & File Number

- 4. Lot No. _____, Recorded Plat _____
- 5. Private Claims _____

A	B	C	D	E	F	G	H	I	J	K	L	M
2	6	5	4	3	2	1						
3												
4	7	8	9	10	11	12						
5												
6	18	17	16	15	14	13						
7												
8	19	20	21	22	23	24						
9												
10	30	29	28	27	26	25						
11												
12	31	32	33	34	35	36						
13												

I, Kenneth L. Ross, in a field survey on OCTOBER, 19 93, do hereby certify that under requirements of P.A. 74, Michigan P.A. of 1970, the corner points mentioned in lines 1 and 2 above were in conformance with regulations and rules therefore as required in the current manual of survey instructions of the United States Department of the Interior, Bureau of Land Management or by a decree of a Court of Law and/or that the corner points mentioned in lines 3, 4 and 5 above were in conformance with the rules of the Michigan Board of Land Surveyors or by a Decree of a Court of Law; established, re-established, monumented, re-monumented, recovered, found as expressed below:

NOTE: Not more than 4 corners, all in the same town and range, may be recorded on this certificate.

A. Description of original monument and accessories and/or subsequent restoration:


F-5 1/4 Corner, Secs. 9 & 16
1838 John Hodgson set Post
1/4 Post in Stream
no witness.

B. Description of corner evidence found and/or method applied in restoring or reestablishing corner:

F-5 1/4 Corner, Secs. 9 & 16
Blass 1959 Fd Ford axle in bucket filled with stones in river 4 ft. from S edge took 3 witness
12" Basswood N 45 E 70.30 14" Maple N 15 E 76.60
14" Elm S 87 E 129.90
Stephens 1971 Fd & used existing Ford axle
Kraft 1972 used Ford axle dist to NW cor = 2629.67
dist to NE cor = 2638.66
Ross 1980 Fd & used axle in river
Undated survey by Bonney used Ford axle
Ross 1992 corner found to be gone established by projecting through Blass 1/64 cor on North sec line through NE cor using Blass distances
14" Maple N 15 E 76.60' 12" Basswood N 45 E 70.30'

C. Description of monument for corner and accessories established to perpetuate locating the position of the corner:

F-5 1/4 Corner, Secs. 9 & 16
Corner (Ford axle) gone re-established from witness & dist. ties from Blass survey set witness corner 90.0 ft. offset on the N-S 1/4 line, and is accepted as the best available evidence of the original corner.
Ross cap Iron in E-W road center line South 28.43'
14" Maple S 60 E 28.18' 20" Maple N 78 E 21.27'
26" W. Pine N 69 W 30.14'
Fence cor post South 55.29'
South river edge N 02 E 85.08'
South river edge N 49 E 73.24'

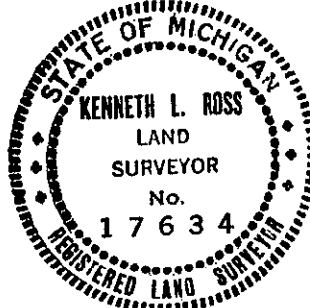

Peer Group Reviewed and Approved
Date: 10-12-93
Kenneth L. Ross
Mason County Surveyor

Signed by [Signature] Date 10-12-93
Surveyor's Michigan License No. 17634