

COMMISSION

LAND CORNER RECORDATION CERTIFICATE  
Filing Requirement of Act 74, Mich. P.A. 1970


For corners in

Located In: \_\_\_\_\_ Corner Code ~~##~~

MASON (County)

1. Public Land Survey T 17NR 15W E-7 E-7  
 T \_\_\_\_\_  
 T \_\_\_\_\_  
 T \_\_\_\_\_

2. Property Controlling S \_\_\_\_\_  
 in Section S \_\_\_\_\_  
 3. Miscellaneous S \_\_\_\_\_  
 Property in Sec. S \_\_\_\_\_

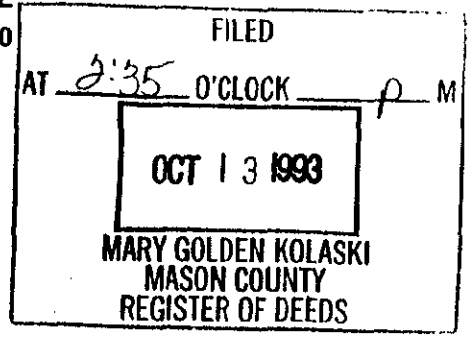

4. Lot No. \_\_\_\_\_, Recorded Plat \_\_\_\_\_  
 5. Private Claims \_\_\_\_\_

	A	B	C	D	E	F	G	H	I	J	K	L	M
2	6		5		4		3		2		1		
3													
4	7		8		9		10		11		12		
5													
6	18		17		16		15		14		13		
7													
8	19		20		21		22		23		24		
9													
10	30		29		28		27		26		25		
11													
12	31		32		33		34		35		36		
13													

I, Kenneth L. Ross, in a field survey on OCTOBER, 19 93, do hereby certify that under requirements of P.A. 74, Michigan P.A. of 1970, the corner points mentioned in lines 1 and 2 above were in conformance with regulations and rules therefore as required in the current manual of survey instructions of the United States Department of the Interior, Bureau of Land Management or by a decree of a Court of Law and/or that the corner points mentioned in lines 3, 4 and 5 above were in conformance with the rules of the Michigan Board of Land Surveyors or by a Decree of a Court of Law; established, re-established, monumented, re-monumented, recovered, found as expressed below:

NOTE: Not more than 4 corners, all in the same town and range, may be recorded on this certificate.

A. Description of original monument and accessories and/or subsequent restoration:

- E-7 Section corner, Secs. 16, 17, 20, & 21  
1838 John Hodgeson set Post  
12" Maple S 59 E 17 lks  
14" Maple N 76 W 20 lks
- F-7 1/4 corner, Secs. 16 & 21  
1838 John Hodgeson set Post  
12" Beech N 42 E 30 lks  
10" Beech S 61 W 7 lks


B. Description of corner evidence found and/or method applied in restoring or reestablishing corner:

- E-7 Section corner, Secs. 16, 17, 20, & 21  
Stephens 1971 set 1" pipe from witness  
Griffin 1973 set 5" X 60" conc. monument Act 74 recorded Liber 1, Page 244 took 4 witness  
Tw Maple 6" & 4" N 45 E 27.95'  
R. Oak 20" S 74 W 41.95'  
4" X 7' Pine Post W 1.6'  
W. Oak 10" N 33 W 76.03'  
Ross 1992 Fd Griffin USFS conc. monument took 3 new witness filed Act 132  
18" W. Oak N 33 W 76.03'  
10" Tw. Maple N 45 E 27.95'  
Cen. 2 Tr. Rd. South 47'
- F-7 1/4 corner, Secs. 16 & 21  
Stephens 1971 set 1" pipe from witness  
Griffin 1973 set 2" X 24" pipe took 3 witness  
24" Maple N 42 W 112.55  
22" W. Pine S 38 E 87 1/2 lks (OBT)  
24" W. Pine N 05 W 25 1/2 lks (OBT)  
Undated survey by Bonney sets 1/2" re-rod using witness took 3 new witness 30" Maple N 42 W 112.55.  
4" Wild Cherry S 30 W 42.10  
4" Wild Cherry N 65 E 27.10  
Ross 1992 Fd Bonney capped Iron & witness took 4 new witness & filed Act 132  
8" W. Oak N 51 W 76.19' 5" W. Oak S 72 W 76.32'  
6" Cherry N 65 E 27.08' 24" Maple N 42 W 112.55'

C. Description of monument for corner and accessories established to perpetuate location of the corner:

- E-7 Section corner, Secs. 16, 17, 20, & 21  
Found USFS conc. monument 1.3' above surface took 7 witness, and is accepted as the best available evidence of the original corner.  
Gov't Post West 1.5'  
10" Tw. Maple N 45 E 28.06'  
18" W. Oak N 33 W 75.96'  
8" Cherry S 81 E 25.08'  
26" R. Oak S 82 W 41.72'  
24" R. Oak N 66 W 68.17'  
Center line E-W 2 Track South
- F-7 1/4 corner, Secs. 16 & 21  
Found 1/2" capped re-bar RLS 12016, replaced with 5/8" X 36" re-bar with 2 1/2" alum. cap, and is accepted as the best available evidence of the original corner.  
8" W. Oak N 51 W 76.19'  
5" W. Oak S 72 W 76.32'  
6" Cherry N 65 E 27.08'  
24" Tri Maple N 42 W 112.55'

Signed by \_\_\_\_\_  
 Surveyor's Michigan License No. 120417634

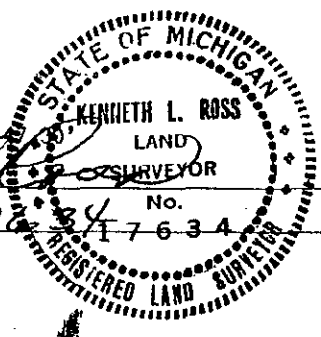

Date 10-13-93

Peer Group Reviewed and Approved  
 Date: 10-13-93  
 Kenneth L. Ross  
 Mason County Surveyor