

SURVEY & REMONUMENTATION

SEP 30 1993
COMMISSION

LAND CORNER RECORDATION CERTIFICATE
FILING REQUIREMENT OF ACT 74, MICH. P.A.1970

FOR CORNERS OF-- LOCATED IN--
 1. PUBLIC LAND SURVEY T. 17N N. 15W E. S., R. W.
 2. PROPERTY CONTROLLING IN SECTION T. N. E. S., R. W.
 3. MISCELLANEOUS PROPERTY IN SECTION T. N. E. S., R. W.
 4. LOT NO. _____, RECORDED PLAT _____
 5. PRIVATE CLAIMS _____

CORNER CODE NUMBER
G3

FILED
AT 2 O'CLOCK P M
SEP 23 1993
MARY GOLDEN KOLASKI
MASON COUNTY
REGISTER OF DEEDS
REGISTER OF DEEDS STAMP AND FILING NUMBER

I, Patrick R. Leemon do hereby certify that under requirements of P.A. 74, Michigan P.A. of 1970, the corner points mentioned in lines 1 and 2 above (identified with circles on index code diagram—over) were, in a field survey on August 23 1993, established, re-established, monumented, re-monumented, recovered or restored as expressed below and in conformance with regulations and rules therefore as required in the current manual of survey instructions of the United States Department of the Interior, Bureau of Land Management or by a decree of a court of law. Furthermore, that the corner points mentioned in lines 3, 4 and 5 above were, in a field survey on _____ 19____, found, recovered, restored, established or re-established as expressed below and in conformance with the rules of the Michigan State Board of Registration for Land Surveyors or, by a Decree of a Court of law:

A. Description of original monument and accessories and/or subsequent restoration:

Section corner common to sec's. 3, 4, 9 & 10 of T17N R15W
 1838 survey by John Hodgson Set Wood Post Pine 8 N55W 24 links B.Ash 6 S49E 28 links
 1936 field notes of A.R.Yale (USFS) Searched but did not find the cor.
 1972 survey by Robert A. Griffin Fd. the rail road spike and replaced w/ a 5" sq.x 36" long conc. monu. w/brass cap. W.Oak 8 N55E 85.52 feet P.Post 4"x7' South 33.07 feet B.Oak 5 S4W 67.88 feet N1/4 10 N89-41-35E 2640.43 feet
 1991 survey by Ross Fd. Griffin Monument W1/4 10 S00-21-15E 2637.57' N1/4 10 S89-43-03E 2642.68' Liber 412 Page 176
 1972 survey by Kraft Rail Road spike for corner. Oak 18 North 33.05 feet J.Pine 8 SW 40.51 feet Oak 18 SE 68.26 feet N1/4 9 West 2638.25 feet

B. Description of corner evidence found and/or method applied in restoring or re-establishing corner:

I found the 5" square by 36" long concrete monument w/ brass cap by Griffin buried 6" below the surface in a monument box and 5.7 feet south of the centerline of the E-W pavement and off a fence line to the south. Liber 1 Page 212 by Griffin documents the history of this corner. The R.Oak North 77 links found by Griffin in 1972 and shown on his certificate is now gone. This monument is accepted as a careful and faithful perpetuation of the position of the original corner.

C. Description of monument for corner and accessories established to perpetuate locating the position of the corner:

Section corner common to sec's. 3, 4, 9 & 10 of T17N R15W
 Monu. 5" sq. by 36" long concrete monu. with 3" brass disk was left in place.
 Witnesses:
 W.Oak 20 N18E 85.00' J.Pine 10 S46W 40.52'
 W.Oak 11 N55E 85.52' B.Oak 17 S45E 68.29'
 W.Oak 10 S6W 67.94'
 B.Oak 22 N10W 32.93'
 P.Post 4"x7' South 33.09'

Peer Group Reviewed and Approved
Date: 9-16-93
Kenneth L. Ross
Mason County Surveyor


SIGNED BY Patrick R. Leemon DATE September 9, 1993

SURVEYOR'S MICHIGAN REGISTRATION NO. 31595

FOR STATE AND UNITED STATES AGENCIES:

SIGNED BY _____ DATE _____
CHIEF OF SURVEY PARTY

APPROVED AND SIGNED BY _____ DATE _____
MICHIGAN REGISTERED LAND SURVEYOR

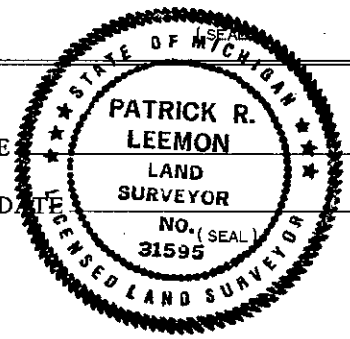

LIBER 3 PAGE 109

SURVEYOR'S MICHIGAN REGISTRATION NO. _____