

1993

COMMISSION

LAND CORNER RECORDATION CERTIFICATE
Filing Requirement of Act 74, Mich. P.A. 1970

FILED
AT 2:35 O'CLOCK P M
OCT 13 1993
MARY GOLDEN KOLASKI
MASON COUNTY
REGISTER OF DEEDS

Register of Deeds Stamp & File Number

For corners in

MASON (County) Located In: Corner Code #

1. Public Land Survey T 17NR 15W G-6 G-7
T R
T R
T R

2. Property Controlling S T R
In Section S T R

3. Miscellaneous S T R
Property in Sec. S T R

4. Lot No. _____, Recorded Plat _____
5. Private Claims _____

I, Kenneth L. Ross, in a field survey on OCTOBER, 19 93, do hereby certify that under requirements of P.A. 74, Michigan P.A. of 1970, the corner points mentioned in lines 1 and 2 above were in conformance with regulations and rules therefore as required in the current manual of survey instructions of the United States Department of the Interior, Bureau of Land Management or by a decree of a Court of Law and/or that the corner points mentioned in lines 3, 4 and 5 above were in conformance with the rules of the Michigan Board of Land Surveyors or by a Decree of a Court of Law; established, re-established, monumented, re-monumented, recovered, found as expressed below:

NOTE: Not more than 4 corners, all in the same town and range, may be recorded on this certificate.

	A	B	C	D	E	F	G	H	I	J	K	L	M
2	6	5	4	3	2								
3													
4	7	8	9	10	11	12							
5													
6	18	17	16	15	14	13							
7													
8	19	20	21	22	23	24							
9													
10	30	29	28	27	26	25							
11													
12	31	32	33	34	35	36							
13													

A. Description of original monument and accessories and/or subsequent restoration:

- G-6 1/4 Corner, Sec. 15 & 16
1838 John Hodgeson set Post
12" Beech N 65 E 18lks
8" Maple S 58 W 36lks
- G-7 Section Corner, Secs. 15, 16, 21, & 22
1838 John Hodgeson set Post
12" Beech S 70 W 19 lks
10" Beech N 37 E 20 lks

B. Description of corner evidence found and/or method applied in restoring or reestablishing corner:


- G-6 1/4 Corner, Sec. 15 & 16
Griffin 1984 set USFS conc. monument Act 74 recorded Liber 2, Page 246 took 5 witness
P. Pole N 59 W 49.76'
B. Oak 8" N 56 E 33.14'
Pine Post 4 E 32.60'
B. Oak 8" S 78 E 67.58'
B. Oak 8" S 50 W 94.78'
Ross 1992 Fd Griffin USFS monument took 3 new witness filed Act 132
10" Oak S 78 E 67.58'
12" B. Oak S 50 W 94.78'
P. Pole N 59 W 49.76'
- G-7 Section Corner, Secs. 15, 16, 21, & 22
Stephens 1971 Fd 1" Iron bar no witness
Griffin 1972 set USFS conc. monument Act 74 recorded Liber 1, Page 215
Ross 1992 Fd Griffin USFS monument took 3 new witness filed Act 132
10" Poplar N 59 W 38.00'
14" W. Oak S 65 W 35.93'
USFS Post S 85 E 32.67'

C. Description of monument for corner and accessories established to perpetuate locating the position of the corner:

- G-6 1/4 Corner, Sec. 15 & 16
Found USFS conc. monument 1' below road surface in center line took 5 new witness, and is accepted as the best available evidence of the original corner. 4" Gov't Post East 32.54'
10" W. Oak S 78 E 67.61' 12" B. Oak S 50 W 94.78'
P. Pole N 59 W 49.76' 20" Quad Maple S 67 W 93.14'
Act 74 by Griffin states monument was set 1/2 way on line between corners, corner was not set by proportionate measurement (from Pat Leemony, Surveyor USFS, who helped set cor) but was set on E-W fence line in center of road.
- G-7 Section Corner, Secs. 15, 16, 21, & 22
Found USFS conc. monument 0.6' below surface in center line of N-S road 15' North of center line of East 2-track took 5 new witness, and is accepted as the best available evidence of the original corner.
10" Poplar N 59 W 38.00'
14" W. Oak S 65 W 35.85'
Gov't Post S 85 E 32.60'
Tri Maple N 16 E 110.06'
Maple S 35 W 50.56'

Signed by Kenneth L. Ross Date 10-12-93

Surveyor's Michigan License No. 17634

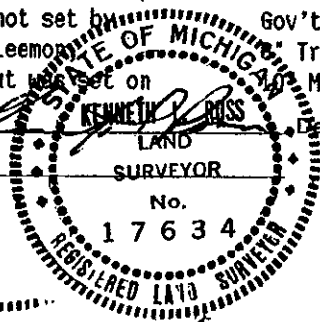

Peer Group Reviewed and Approved
Date: 10-13-93
Kenneth L. Ross
Mason County Surveyor