


1033

OCCT/1033/1033

LAND CORNER RECORDATION CERTIFICATE
Filing Requirement of Act 74, Mich. P.A. 1970

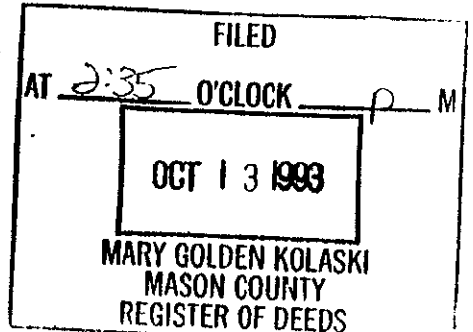

For corners in

Form with fields for MASON (County), Located In, Corner Code, and numbered sections 1-5 for Public Land Survey, Property Controlling, Miscellaneous, and Private Claims.

Register of Deeds Stamp & File Number

I, Kenneth L. Ross, in a field survey on OCTOBER 19 93 do hereby certify that under requirements of P.A. 74, Michigan P.A. of 1970, the corner points mentioned in lines 1 and 2 above were in conformance with regulations and rules therefore as required in the current manual of survey instructions of the United States Department of the Interior, Bureau of Land Management or by a decree of a Court of Law and/or that the corner points mentioned in lines 3, 4 and 5 above were in conformance with the rules of the Michigan Board of Land Surveyors or by a Decree of a Court of Law; established, re-established, monumented, re-monumented, recovered, found as expressed below:

Grid table with columns A-L and rows 2-13, containing numbers 1-36.

NOTE: Not more than 4 corners, all in the same town and range, may be recorded on this certificate.

A. Description of original monument and accessories and/or subsequent restoration:

- List of original monuments for G-6 (1/4 Corner, Sec. 15 & 16) and G-7 (Section Corner, Secs. 15, 16, 21, & 22).

B. Description of corner evidence found and/or method applied in restoring or reestablishing corner:


- List of corner evidence for G-6 and G-7, including witness measurements and monument details.

C. Description of monument for corner and accessories established to perpetuate locating the position of the corner:

- List of monuments established for G-6 and G-7, including witness measurements and monument details.

Signed by KENNETH L. ROSS, LAND SURVEYOR

Surveyor's Michigan License No. 17634

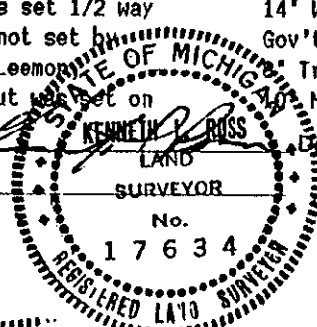

Date 10-12-93

FORM APPROVED BY MICHIGAN STATE BOARD OF LAND SURVEYORS, JAN. 20, 1971 REVISED MAY 14, 1975 REVISED JAN., 1983

Peer Group Reviewed and Approved Date: 10-12-93 Kenneth L. Ross Mason County Surveyor