

SURVEY & REMONUMENTATION

FEB 08 2000

LAND CORNER RECORDATION CERTIFICATE

Filing Requirement of Act 74, Mich. P.A. 1970


For corners in **SECTION**

Mason
(County)

Located In:

Corner Code #

- | | | |
|------------------------------------|-------------------------|-------|
| 1. Public Land Survey | T 17N R 15W | G-09 |
| | T _____ R _____ | _____ |
| | T _____ R _____ | _____ |
| | T _____ R _____ | _____ |
| 2. Property Controlling in Section | S _____ T _____ R _____ | _____ |
| | S _____ T _____ R _____ | _____ |
| 3. Miscellaneous Property in Sec. | S _____ T _____ R _____ | _____ |
| | S _____ T _____ R _____ | _____ |

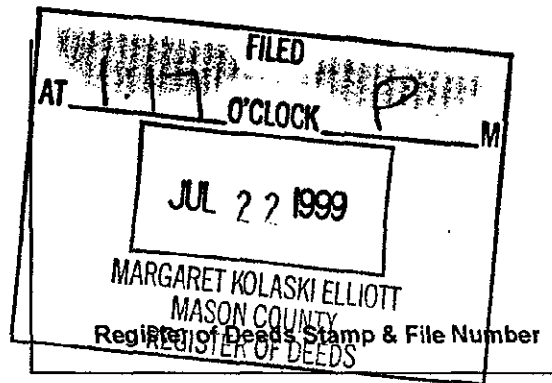

4. Lot No. _____, Recorded Plat _____
5. Private Claims _____

I, Kenneth L. Ross, in a field survey on May 15, 1999, do hereby certify that under requirements of P.A. 74, Michigan P.A. of 1970, the corner points mentioned in lines 1 and 2 above were in conformance with regulations and rules therefore as required in the current manual of survey instructions of the United States Department of the Interior, Bureau of Land Management or by a decree of a Court of Law and/or that the corner points mentioned in lines 3, 4 and 5 above were in conformance with the rules of the Michigan Board of Land Surveyors or by a Decree of a Court of Law; established, re-established, monumented, re-monumented, recovered, found as expressed below:

NOTE: Not more than 4 corners, all in the same town and range, may be recorded on this certificate.

A. Description of original monument and accessories and/or subsequent restoration:

G-09 Section Corner for Sections 21, 22, 27 and 28, T17N-R15W.

1838, John Hodgson, G.L.O. (subdivision survey)
Set post @ 80 chs.
#1 Beech 8" S 23 E 14 lks. (9.24')
#2 Beech 6" N 26 W 24 lks. (15.84')

Undated Mason County Road Comm.
Elm Stake
#3 Hemlock 14" N 44 W 43.56'
#4 Beech 18" N 46 E 80.52'

1974, Robert A. Griffin, RLS #13584 LCRC, L.1, p.242
Established corner, then set a 5" sq. x 36" long
Concrete Monument with brass cap.
#5 Maple 3" N 23 E 68.74'
#6 Stone with "X" mark S 57 W 39.33'
#7 Maple 5" N 54 W 57.18'
#8 Pine Post 4" x 7' West 32.73'

1998, Kenneth Ross, RLS 17634
Found and used Griffins Conc. Monument, in Cadastral Survey for U.S.F.S. # 98339s. (Co. Surveyor Records)
#9 Black Ash 10" S 46 W 67.63'
#10 Hemlock 12" S 78 E 97.62'
#11 Black Ash 17" S 60 W 46.65'

B. Description of corner evidence found and/or method applied in restoring or reestablishing corner:

G-09 Section Corner for Sections 21, 22, 27 and 28, T17N-R15W.

On February 5, 1999, I Kenneth Ross found a 5" Sq. concrete monument with 3" brass cap, set by Robert Griffin, and used by me in previous survey, NOTE monument is stamped to identify the corner, 1 foot below gravel road, 7' South and 7' East of road intersection. I found no evidence to dispute this location for the corner.


Condition of recorded witnesses are as follows: #1 thru #6 are gone or destroyed. Witnesses #7 thru #11 are in and in good condition. I found no other evidence to dispute the location of this corner.

C. Description of monument for corner and accessories established to perpetuate locating the position of the corner:

G-09 Section Corner for Sections 21, 22, 27 and 28, T17N-R15W.

I accepted Griffins 5" square x 36" long concrete monument with brass cap, stamped to identify the corner as a substantial marker for the corner, and this corner is accepted as a careful and faithful re-establishment of the position of the original corner.
ext. BT #7 Maple, 9" N 54° W 57.18' (60d spike in SW side of tree)
ext. BP #8 Pine Post, 4" X 7', West, 32.73' (16d nail and cap, South side)
ext. BT #9 Black Ash 10" S 46° W 67.63' (60d spike in SE side of tree)
ext. BT #10 Hemlock 12" S 78° E 97.62' (60d spike in North side of tree)
ext. BT #11 Black Ash 17" S 60° W 46.65' (60d spike in NW side of tree)

Signed by [Signature] Date 7-21-99
Surveyor's Michigan License No. 17634

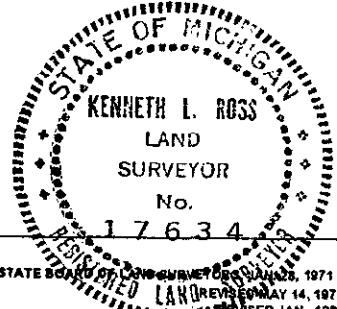

FORM APPROVED BY MICHIGAN STATE BOARD OF LAND SURVEYORS JAN 28, 1971
REVISED MAY 14, 1972
REVISED JAN, 1998
ADAPTED FOR WORD PROCESSING MARCH, 1999

Peer Group Reviewed and Approved
Date: 7-14-99
[Signature]
Kenneth L. Ross
Mason County Surveyor