

SURVEY & REMONUMENTATION

FEB 08 2000

LAND CORNER RECORDATION CERTIFICATE

Filing Requirement of Act 74, Mich. P.A. 1970

SECTION

FILED
AT 1:20 O'CLOCK P M
JUL 22 1999
MARGARET KOLASKI ELLIOTT
MASON COUNTY
REGISTER OF DEEDS
Register of Deeds Stamp & File Number

For corners in MASON (County) Located In: Corner Code #

1. Public Land Survey T 17N R 15W G-10
T _____ R _____
T _____ R _____
T _____ R _____

2. Property Controlling S _____ T _____ R _____
in Section S _____ T _____ R _____

3. Miscellaneous S _____ T _____ R _____
Property in Sec. S _____ T _____ R _____

4. Lot No. _____ Recorded Plat _____
5. Private Claims _____

I, Kenneth L. Ross, in a field survey on May 15, 1999, do hereby certify that under requirements of P.A. 74, Michigan P.A. of 1970, the corner points mentioned in lines 1 and 2 above were in conformance with regulations and rules therefore as required in the current manual of survey instructions of the United States Department of the Interior, Bureau of Land Management or by a decree of a Court of Law and/or that the corner points mentioned in lines 3, 4 and 5 above were in conformance with the rules of the Michigan Board of Land Surveyors or by a Decree of a Court of Law; established, re-established, monumented, re-monumented, recovered, found as expressed below:

NOTE: Not more than 4 corners, all in the same town and range, may be recorded on this certificate.

A. Description of original monument and accessories and/or subsequent restoration:

- G-10 1/4 Corner for Sections 27 and 28, T17N-R15W.
- 1838, John Hodgson, G.L.O., (subdivision survey)
Set Post @ 40 chs. (1320')
#1 Beech 6" N 08 W 8 lks. (5.28')
#2 White Oak 12" S 47 E 9 lks. (5.94')
 - 1976, Kenneth Ross, RLS #17634
Set 1/2" Re-Rod @ old East-West fence line and center-line of road. file no. B-107 and B-199
#3 Maple 12" S 45 E 35.02'
#4 Maple 12" N 35 W 33.33'
#5 Tw. Maple 16" S 50 W 29.90'

- 1998, Kenneth Ross, RLS# 17634 (Co. Surv. Records)
Found 3/4" Iron Pipe in Cadastral Survey for U.S.F.S. file no. 98339s.
#6 Red Maple Tw. 8"-9" N 45 E 41.82'
#7 Sugar Maple 28" S 42 E 35.48'
#8 Sugar Maple 26" S 82 W 25.10'
#9 Red Oak 24" S 46 W 33.32'

	A	B	C	D	E	F	G	H	I	J	K	L	M
1													
2	6	5	4	3	2	1							
3													
4	7	8	9	10	11	12							
5													
6	18	17	16	15	14	13							
7													
8	19	20	21	22	23	24							
9													
10	30	29	28	27	26	25							
11													
12	31	32	33	34	35	36							
13													

B. Description of corner evidence found and/or method applied in restoring or reestablishing corner:

G-10 1/4 Corner for Sections 27 and 28, T17N-R15W.


Found 3/4" X 24" pipe 3' West of the center line of Campbell Road opposite old fence line to the West. Witnesses (1), (2) and (4) have been destroyed. Witnesses (3), (5), (6), (7), (8) and (9) are standing and in good condition. I found no other evidence to dispute the location of this corner.

C. Description of monument for corner and accessories established to perpetuate locating the position of the corner:

G-10 1/4 Corner for Sections 27 and 28, T17N-R15W.

I replaced the 3/4" X 24" pipe with a standard 3" Cast Iron Harrison Monument, stamped "Mason County Monument", 1.0' below the gravel surface of Campbell Road. This corner accepted as the best available evidence of the position of the original corner.

- (3), Maple, 15", existing 60d spike NE side, S45°E, 35.02'
- (5) Twin Maple, 16" at base, existing 60d spike NW side, S50°W, 29.90'
- (6) Twin Red Maple, 8" & 9", existing 60d spike NW side, N45°E, 51.82'
- (7) Sugar Maple, 28", existing 60d spike SW side, S42°E, 35.48'
- (8) Sugar Maple, 26", existing 60d spike, south side, S82°W, 25.10'
- (9) Red Oak, 24", existing 60d spike, NW side, S46°W, 33.32'
- (10) Capped iron by Gordon Bonney, West 33.00'

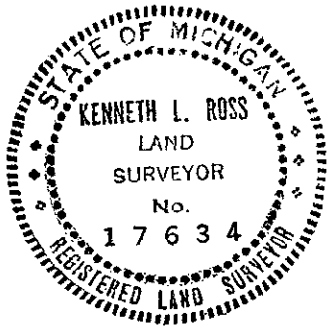

Signed by [Signature] Date 7-21-99
Surveyor's Michigan License No. 17634

Approved by Peer Review Group on 7-14-99
Kenneth L. Ross, County Representative [Signature]

FORM APPROVED BY MICHIGAN STATE BOARD OF LAND SURVEYORS, JAN. 28, 1977
REVISED MAY 14, 1975
REVISED JAN, 1983
ADAPTED FOR WORD PROCESSING MARCH, 1993