

FEB 08 2000

SECTION

LAND CORNER RECORDATION CERTIFICATE

Filing Requirement of Act 74, Mich. P.A. 1970

For corners in  
Mason  
(County)

Located In: Corner Code #

1. Public Land Survey T 17N R 15W G-11  
T R  
T R  
T R


2. Property Controlling S T R  
in Section S T R

3. Miscellaneous S T R

Property in Sec. S T R

4. Lot No. Recorded Plat

5. Private Claims

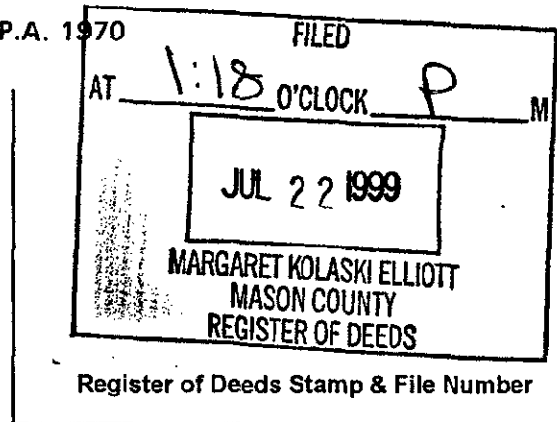

	A	B	C	D	E	F	G	H	I	J	K	L	M
1													
2	6	5	4	3	2	1							
3													
4	7	8	9	10	11	12							
5													
6	18	17	16	15	14	13							
7													
8	19	20	21	22	23	24							
9													
10	30	29	28	27	26	25							
11													
12	31	32	33	34	35	36							

I, Kenneth L. Ross, in a field survey on May 15, 1999, do hereby certify that under requirements of P.A. 74, Michigan P.A. of 1970, the corner points mentioned in lines 1 and 2 above were in conformance with regulations and rules therefore as required in the current manual of survey instructions of the United States Department of the Interior, Bureau of Land Management or by a decree of a Court of Law and/or that the corner points mentioned in lines 3, 4 and 5 above were in conformance with the rules of the Michigan Board of Land Surveyors or by a Decree of a Court of Law; established, re-established, monumented, re-monumented, recovered, found as expressed below:

NOTE: Not more than 4 corners, all in the same town and range, may be recorded on this certificate.

A. Description of original monument and accessories and/or subsequent restoration:

G-11, Section corner common to Sections 27, 28, 33 and 34  
GLO by John Hodgson undated, Mason Co. Road Comm  
4<sup>th</sup> quarter, 1838 C. Landon, Monument "flat stone"  
Set post (4) White Pine, 28", N67°W, 69.30'  
(1) Aspen, 18", N52°W, 29 links(19.14') (5) White Pine, 18", N20° 30'E, 76.56'  
(2) Hemlock, 20", S66°E, 36 links(23.76') (6) White Pine, 24", S77°W, 13.53'

May, 1901, Book 2, page 126 & 127 1960, George Blass, Lake Co. Surveyor  
And book 4, page 38, R.O. Towns Field Notes, "Found 3/4" Iron rod, w/wood  
"Planted Stone east of large boulder", stake & stones  
(3) Pine Sapling, S80 1/4°W, 23 links(15.18') (7) Elm, 18", S45°E, 39.25' (spike & cap)  
Distance East to H-11, 2647.92' (8) Elm, 10", N41°E, 45.08' (spike & cap)  
Distance South to G-12, 2640.00' (9) Poplar, 8", S60°W, 42.25' (spike and cap)

1972, Robert Griffin, LCRC Liber 1, page 216  
Replaced 3/4" pipe with 5"sq. monument.  
(10) Maple, 4", N48°E, 38.48'  
(11) Tw Maple, 8"-8", N26°W, 45.85'  
(12) Pine Post, 4"X7', West, 33.00'

1976, James T. Nordlund, Act 132, No Comment on Corner. Witnesses (10), (11) And 12 given.


1998, K.L. Ross, Act 132 Found Griffin Mon (broken)  
(13) Red Oak, 8", N86°W, 24.8'  
(14) Maple, 5", S71°E, 37.62'

B. Description of corner evidence found and/or method applied in restoring or reestablishing corner:

G-11, Section corner common to Sections 27, 28, 33 and 34  
Found a broken 5" square Monument as described by Griffin above. Witness, (1) thru (9), have been destroyed witnesses (10) thru (14) are standing and in good condition. I found no other evidence to dispute the location of this corner.

C. Description of monument for corner and accessories established to perpetuate locating the position of the corner:

G-11, Section corner common to Sections 27, 28, 33 and 34  
I replaced the broken 5" square monument with a standard 3" Cast Iron Harrison Monument, stamped "Mason County Monument", 1.0' below the gravel surface of Campbell Road. This corner accepted as the best available evidence of the position of the corner.  
(10) Maple, 6", dock spike, SE side, N48°E, 38.48'  
(11) Twin Maple, 8" & 8", dock spike East side, N26°W, 45.85'  
(12) Pine Post, 4"X 7', 60d nail and cap, south side, West, 33.00'  
(13) Red Oak, 8", existing 60d spike, South side, N86°W, 24.80'  
(14) Sugar Maple, 5", existing 60d spike NE side, S71°E, 37.62'

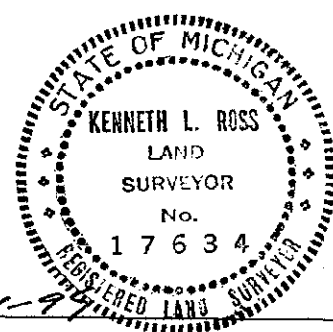

Signed by [Signature] Date 7-21-99

Surveyor's Michigan License No. 17634

Peer Group Reviewed and Approved  
Date: 7-14-99  
[Signature]  
Kenneth L. Ross