

SURVEY & REMONUMENTATION

SEP 30 1993

LAND CORNER RECORDATION CERTIFICATE

COMMISSION

FILING REQUIREMENT OF ACT 74, MICH. P.A.1970

FOR CORNERS OF--:	LOCATED IN--:	CORNER CODE NUMBER	FILED
1. PUBLIC LAND SURVEY _____	T. <u>17N</u> N. <u>15W</u> E. S., R. W.	H5	AT <u>2</u> O'CLOCK <u>P</u>
2. PROPERTY CONTROLLING IN SECTION _____	T. _____ N. S., R. E. W.		
3. MISCELLANEOUS PROPERTY IN SECTION _____	T. _____ N. S., R. E. W.		
4. LOT NO. _____, RECORDED PLAT _____			
5. PRIVATE CLAIMS _____			

SEP 23 1993

MARY GOLDEN KOLASKI
MASON COUNTY REGISTER OF DEEDS

REGISTER OF DEEDS STAMP AND FILING NUMBER

I, Patrick R. Leemon do hereby certify that under requirements of P.A. 74, Michigan P.A. of 1970, the corner points mentioned in lines 1 and 2 above (identified with circles on index code diagram—over) were, in a field survey on August 23 1993 established, re-established, monumented, re-monumented, recovered or restored as expressed below and in conformance with regulations and rules therefore as required in the current manual of survey instructions of the United States Department of the Interior, Bureau of Land Management or by a decree of a court of law. Furthermore, that the corner points mentioned in lines 3, 4 and 5 above were, in a field survey on _____ 19____, found, recovered, restored, established or re-established as expressed below and in conformance with the rules of the Michigan State Board of Registration for Land Surveyors or, by a Decree of a Court of law:

A. Description of original monument and accessories and/or subsequent restoration:

1/4 corner common to sections 10 and 15 of T17N R15W

1838 survey by John Hodgson Pine 12" for the corner. 1936 field notes of L.Harden(USFS) Searched but did not find the corner.

1939 C.Landon may have looked for the corner. He doesn't mention what he found but did provide the following two witnesses. W.Pine 20" N62-30E 58 links and a W.Pine 30 S23-30W 100 links. There is a note that says "This may be wrong - check. P.W.A." I looked for these two pines and although there are several old W.Pine stumps in the area I was unable to make them fit Landon's notes. Also none of the stumps appear to be of sufficient size. The stumps that are present appear to be too badly rotted to have been live trees in 1939.

B. Description of corner evidence found and/or method applied in restoring or re-establishing corner:

In 1984 I set a 5" square by 60" long concrete monument w/ brass cap under Robert Griffin's registration number by single proportional measurement between the SE and SW of 10. I have reviewed my procedures and made a second search for Landon's witnesses and accept this monument as a careful and faithful reestablishment of the position of the original corner. Inadvertently no certificate was ever filed on this corner prior to this.

C. Description of monument for corner and accessories established to perpetuate locating the position of the corner:

1/4 corner common to sections 10 and 15 of T17N R15W
Monu. 5" sq. by 60" long concrete monu. with 3" brass disk was left in place.

Witnesses:
R.Maple 10 S86W 62.58'
P.Post 4"x7' West 2.35'
B.Oak 10 S32W 26.92'
B.Oak 14 N85E 80.76'
R.Maple 5 N5W 62.05'

Peer Group Reviewed and Approved
Date: 9-16-93
Keriffeth L. Ross
Mason County Surveyor


SIGNED BY Patrick R. Leemon DATE September 9, 1993

SURVEYOR'S MICHIGAN REGISTRATION NO. 31595

FOR STATE AND UNITED STATES AGENCIES:

SIGNED BY _____ DATE _____
CHIEF OF SURVEY PARTY

APPROVED AND SIGNED BY _____
MICHIGAN REGISTERED LAND SURVEYOR

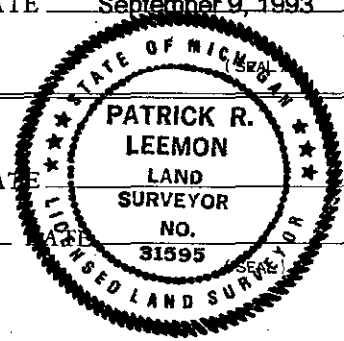

LIBER 3PAGE 116

SURVEYOR'S MICHIGAN REGISTRATION NO. _____