

FEB 08 2000

LAND CORNER RECORDATION CERTIFICATE

Filing Requirement of Act 74, Mich. P.A. 1970

SECTION

For corners in


Mason

(County)

Located In:

Corner Code #

- 1. Public Land Survey T 17N R 15W H-09
- T R
- T R
- T R
- 2. Property Controlling S T R
- in Section S T R
- 3. Miscellaneous S T R
- Property in Sec. S T R

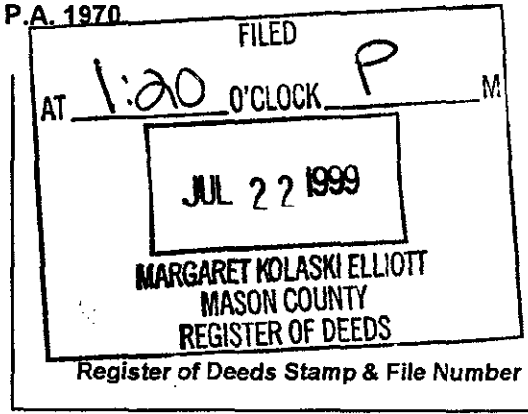

- 4. Lot No. _____, Recorded Plat _____
- 5. Private Claims _____

	A	B	C	D	E	F	G	H	I	J	K	L	M
1													
2	6	5	4	3	2	1							
3													
4	7	8	9	10	11	12							
5													
6	18	17	16	15	14	13							
7													
8	19	20	21	22	23	24							
9													
10	30	29	28	27	26	25							
11													
12	31	32	33	34	35	36							
13													

I, Kenneth L. Ross, in a field survey on May 15, 1999, do hereby certify that under requirements of P.A. 74, Michigan P.A. of 1970, the corner points mentioned in lines 1 and 2 above were in conformance with regulations and rules therefore as required in the current manual of survey instructions of the United States Department of the Interior, Bureau of Land Management or by a decree of a Court of Law and/or that the corner points mentioned in lines 3, 4 and 5 above were in conformance with the rules of the Michigan Board of Land Surveyors or by a Decree of a Court of Law; established, re-established, monumented, re-monumented, recovered, found as expressed below:

NOTE: Not more than 4 corners, all in the same town and range, may be recorded on this certificate.

A. Description of original monument and accessories and/or subsequent restoration:

- H-09 1/4 Corner for Section 22 and 27, T17N-R15W.
- 1838, John Hodgson, G.L.O., (subdivision survey)
Set Post @ 39.84 chs. (2629.84')
#1 Hemlock 24" S 50 E 24 lks (15.84')
#2 Hemlock 8" N 50 W 14 lks. (9.24')
- 1986, Kenneth Ross, RLS #17634
Found existing 1/2" re-rod, file no. B-199
#3 White Oak 14" S 14 W 55.58'
#4 Power Pole N 74 W 46.17'
#5 Cherry 10" N 15 E 52.41'

- 1998, Kenneth Ross, RLS #17634
Found existing 1/2" re-rod, file no. 98339s.
Found existing witnesses #3, #4 and #5.
#6 Red Oak Twin 4" and 7" S 26 W 57.50'
Set this corner by single proportionate measurement
On a previous survey for Wideman in Section 22.

B. Description of corner evidence found and/or method applied in restoring or reestablishing corner:

H-09 1/4 Corner for Section 22 and 27, T17N-R15W.


Found 1/2" X 24" Re-rod, on North edge of Gravel Surface of Anthony Road. Witnesses (1) and (2) have been destroyed. Witnesses (3) thru (6) are standing and in good condition. I found no other evidence to dispute the location of This corner.

C. Description of monument for corner and accessories established to perpetuate locating the position of the corner:

H-09 1/4 Corner for Section 22 and 27, T17N-R15W.

I replaced the 1/2" X 24" re-bar as described above with a standard 3" Cast Iron Harrison Monument, stamped "Mason County Monument", 1.0' below the gravel surface of Anthony Road on the North edge of gravel surface. This corner is accepted as the best available evidence of the position of the original corner.

- (3) White Oak, 16", existing 60d spike, SE side, S14°W, 55.58'
- (4) Power Pole, existing 60d spike, South side, N74°W, 46.17'
- (5) Cherry, 12", existing 60d spike West side, N15°E, 52.41'
- (6) Red Oak, Twin 4" and 7", existing 60d spike, SE side, S26°E, 57.40' (Note bearing differs from Ross 1998 survey)
- (7) 5" X 7" X 5' railroad Tie, 60d spike, West side, S00°E, 55.73'

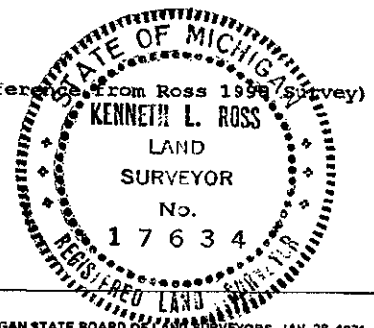

Signed by [Signature]
Surveyor's Michigan License No. 17634

Date 7-21-99

Peer Group Reviewed and Approved
Date: 2-14-99
[Signature]
Kenneth L. Ross
Mason County Surveyor