

FEB 08 2000

SECTION

LAND CORNER RECORDATION CERTIFICATE

Filing Requirement of Act 74, Mich. P.A. 1970

For corners in
Mason
(County)

Located In: _____ Corner Code # _____

1. Public Land Survey T 17N R 15W H-11
T _____ R _____
T _____ R _____
T _____ R _____


2. Property Controlling S _____ T _____ R _____
in Section S _____ T _____ R _____

3. Miscellaneous S _____ T _____ R _____

Property in Sec. S _____ T _____ R _____

4. Lot No. _____, Recorded Plat _____

5. Private Claims _____

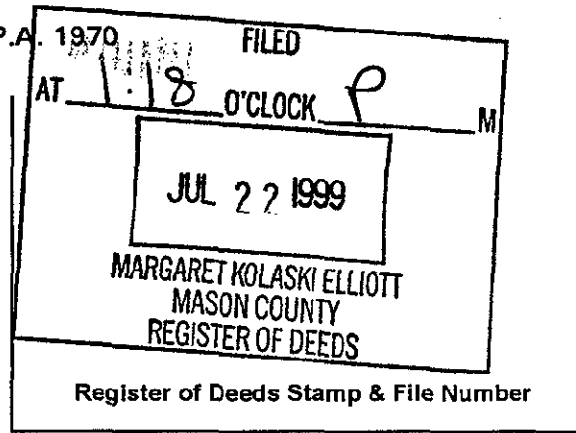

1	A	B	C	D	E	F	G	H	I	J	K	L	M
2	6	5	4	3	2	1							
3													
4	7	8	9	10	11	12							
5													
6	18	17	16	15	14	13							
7													
8	19	20	21	22	23	24							
9													
10	30	29	28	27	26	25							
11													
12	31	32	33	34	35	36							
13													

I, Kenneth L. Ross, in a field survey on May 22, 1999, do hereby certify that under requirements of P.A. 74, Michigan P.A. of 1970, the corner points mentioned in lines 1 and 2 above were in conformance with regulations and rules therefore as required in the current manual of survey instructions of the United States Department of the Interior, Bureau of Land Management or by a decree of a Court of Law and/or that the corner points mentioned in lines 3, 4 and 5 above were in conformance with the rules of the Michigan Board of Land Surveyors or by a Decree of a Court of Law; established, re-established, monumented, re-monumented, recovered, found as expressed below:

NOTE: Not more than 4 corners, all in the same town and range, may be recorded on this certificate.

A. Description of original monument and accessories and/or subsequent restoration:

H-11, Corner Common to Sections 27 and 34, T.17N., R.15W.,
GLO, John Hodgson December, 1886, Act 132
4th quarter, 1838 K.L. Ross, "Set 4" X 4" re-bar"
Set quarter sec. post From Blass Plat of P.M. River Rapids
(1) Beech, 14", N13°E, 25 links (16.50') (3) Fence to North 3' East
(2) Beech, 6", S56°W, 22 links (14.52') (4) On Line to with E-W fence
(5) Beech, 20", N48°W, 24.55'
(6) Oak, 18", S83°E, 38.90'
(7) Maple, 18", N02°E, 23.59'
No Distances given East or West

May, 1901, Book 2, Page 126 & 127

And Book 4, page 38, R.O. Towns
"Set quarter sec. Post by Measurement"
No Witnesses Given
Distance West to G-11, 2647.92'
Distance East to I-11, 2647.92'

October, 1998, Act 132, K.L. Ross, "ex. 5/8" iron"
Witnesses (5), (6), and (7) Given
Distance West to G-11, 2643.32'
Distance East to I-11, 2642.04'

B. Description of corner evidence found and/or method applied in restoring or reestablishing corner:

H-11, Corner Common to Sections 27 and 34, T.17N., R.15W.,

Found 5/8" X 4' Re-bar, 1.0' West of new 8" dia. treated post. Witnesses ((1), (2), have been destroyed. Witnesses (3) and (4) are lying on the ground and in bad condition. Witnesses (5), (6) and (7) are standing and in good condition. I found no other evidence to dispute the location of this corner.

C. Description of monument for corner and accessories established to perpetuate locating the position of the corner:

H-11, Corner Common to Sections 27 and 34, T.17N., R.15W.,
I replaced the 5/8" X 4" re-bar as described above with a standard 3" Cast Iron Harrison Monument, stamped "Mason County Monument", flush with the existing ground, 1.0' west of a treated 8" dia. fence post. New fence to South, old fence line to North, East and West. This corner accepted as the best available evidence of the position of the original corner.

- (5) Beech 22", existing 60d spike North side, N48°W, 24.55'
- (6) Oak, 20", existing 60d spike South side, S83°E, 38.90'
- (7) Maple, 20", existing 60d spike, West side, N02°E, 23.59'
- (NBT), (8) Triple Beech, 3-12", set 60d spike, North side, S76°W, 23.18'

Signed by [Signature]
Surveyor's Michigan License No. 17634

Date 7-21-99



Peer Group Reviewed
and Approved
Date: 7-21-99
[Signature]
Kenneth L. Ross
Mason County Surveyor