

SURVEY & REMONUMENTATION

JAN 23 2001 LAND CORNER RECORDATION CERTIFICATE

Filing Requirement of Act 74, Mich. P.A. 1970

SECTION

For corners In: Located In: Corner Code #

Mason County

Public Land Survey T 17N R 15W I-6
 T _____ R _____
 T _____ R _____
 T _____ R _____
 Property Controlling S _____ T _____ R _____
 in Section S _____ T _____ R _____
 Miscellaneous S _____ T _____ R _____
 Property in Sec. S _____ T _____ R _____

Lot No. _____ Recorded Plat _____
 Private Claims _____

Theodore H. Weinert, in a field survey on September 26, 2000, Do hereby certify that under requirements of P.A. 74, Michigan P.A. of 1970, the corner points mentioned in lines 1 and 2 above were in conformance with regulations and rules therefore as required in the current manual of survey instructions of the United States Department of the Interior, Bureau of Land Management or by a decree of a Court of Law and/or that the corner points mentioned in lines 4 and 5 above were in conformance with the rules of the Michigan Board of Land Surveyors or by a Decree of a Court of Law; established, re-established, monumented, re-monumented, discovered, found as expressed below:

NOTE: Not more than 4 corners, all in the same town and range, may be recorded on this certificate.

Description of original monument and accessories and/or subsequent restoration:
Corner Common to Sections 14 and 15, T.17N., R.15W.,

Original Government Survey Completed by R.A. Griffin, RLS 13584, LCRC, 08/08/84 and 1/17/85
 Lodgson, 1838 Liber 2, page 246 and Liber 2, page 250
 Set quarter section post "Set this corner by proportional measurement"
 1) Pine, 12", N63°E, 14 links, (9.24') Set 5" Square by 60" Long Concrete Monument/w brass disk
 2) Pine, 10", S33°W, 16 links (10.56') (6) R. Pine, 5", S39°E, 64.85'
 (7) R. Pine, 6", S48°W, 60.10'
 (8) W. Oak, 22", N51°W, 97.09'
 (9) Pine Post, 5", South, 2.05'

Kenneth L. Ross, PLS 17634
 survey dated 10/31/95
 "Fd. USFS Monument"
 No witnesses given
 (10) Corner I-5, T.17N., R.15W., North, 2658.71'
 (11) Corner I-7, T.17N., R.15W., South, 2658.11'

Description of corner evidence found and/or method applied in restoring or reestablishing corner:
Corner Common to Sections 14 and 15, T.17N., R.15W.,

Found the 5" square Concrete Monument as described by Griffin, above, the top of which extends approximately 1.5' above the ground. Witnesses (1) thru (5) have been destroyed. Witnesses (6) thru (11) are standing and in good condition although some of the nails have been overgrown. I found no other evidence to dispute the location of this corner.

Description of monument for corner and accessories established to perpetuate locating the position of the corner:
Corner Common to Sections 14 and 15, T.17N., R.15W.,

Left the 5" square Concrete Monument, projecting approximately 1.5' above ground, in place. This corner accepted as a careful and faithful re-establishment of the position of the original corner.


-) Set 60d spike, NE side of 10" Red Pine, S39°E, 64.96'
-) Set 60d spike, SE side of 12" Red Pine, S48°W, 60.09'
-) Existing 10" Dock Spike, SW side of 32" White Oak, N51°W, 97.09'
-) Existing 16d nail and steel shiner (rusty), West side of treated 5" diameter round post, South, 2.05'
- 0) Corner I-5, T.17N., R.15W., North, 2658.71' (by Ross above not checked)
- 1) Corner I-7, T.17N., R.15W., South, 2658.11' (by Ross above not checked)

Witnessed by Theodore H. Weinert Date 10/6/00
 Theodore H. Weinert

Surveyor's Michigan License No. 19846

LIBER 5 PAGE 58

Approved by Peer Review Group on 10/5/00
 Kenneth L. Ross, County Representative [Signature]

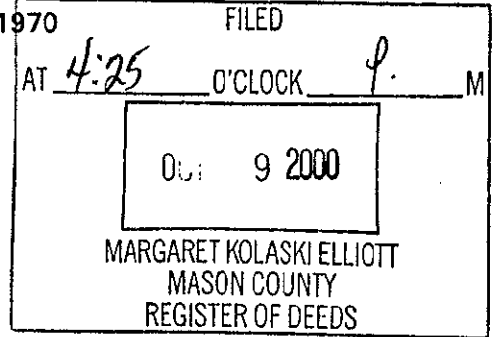

Register of Deeds Stamp & File Number

	A	B	C	D	E	F	G	H	I	J	K	L	M
1													
2	6	5	4	3	2	1							
3													
4	7	8	9	10	11	12							
5													
6	18	17	16	15	14	13							
7													
8	19	20	21	22	23	24							
9													
10	30	29	28	27	26	25							
11													
12	31	32	33	34	35	36							
13													

