

SURVEY & REMONUMENTATION

JAN 23 2001


LAND CORNER RECORDATION CERTIFICATE

Filing Requirement of Act 74, Mich. P.A. 1970

SECTION

For corners In: Located In: Corner Code #
Mason County

1. Public Land Survey T 17N R 15W I-7
2. Property Controlling in Section S _____ T _____ R _____
3. Miscellaneous S _____ T _____ R _____
- Property in Sec. S _____ T _____ R _____

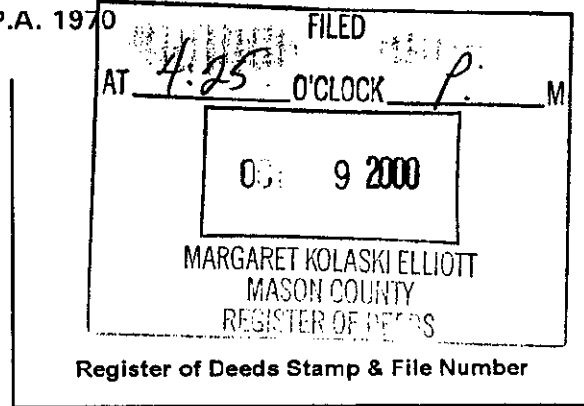

4. Lot No. _____, Recorded Plat _____
5. Private Claims _____

I, Theodore H. Weinert, in a field survey on September 3, 2000, Do hereby certify that under requirements of P.A. 74, Michigan P.A. of 1970, the corner points mentioned in lines 1 and 2 above were in conformance with regulations and rules therefore as required in the current manual of survey instructions of the United States Department of the Interior, Bureau of Land Management or by a decree of a Court of Law and/or that the corner points mentioned in lines 3, 4 and 5 above were in conformance with the rules of the Michigan Board of Land Surveyors or by a Decree of a Court of Law; established, re-established, monumented, re-monumented, recovered, found as expressed below:

NOTE: Not more than 4 corners, all in the same town and range, may be recorded on this certificate.

A. Description of original monument and accessories and/or subsequent restoration:
Corner Common to Sections 14, 15, 22 and 23, T.17N., R.15W.,

Original Government Survey by Hodgson, 1838

- (1) Hemlock, 6", N68°W, 8 links, (5.28')
(2) Lynn, 12", S 59°E, 10 links (6.60')

Survey by Kenneth B. Stephens, RLS Dated October, 1955, Tied this corner. Does not state what he found and no witnesses given.

Survey by Kenneth B. Stephens, RLS Dated July, 1962, Tied this corner. Does not state what he found and no witnesses given.

R.A. Griffin, RLS 13584 LCRC, 06/06/73
Liber 1, page 222, "fd 1/4" Iron pipe"
Replaced the 1/4" Iron pipe with 5" square by 60" Concrete Monument/w brass disk
(3) 10" Dock Spike, West side of W Oak, 8", S5°E, 24.98'
(4) 10" Dock Spike, NW side of Maple, 6", S27°W, 9.05'
(5) 10" Dock Spike, SE side of Beech, 3", N18°W, 19.73'
(6) 4" X 7" Square Post, North 1.6'

Survey by Robert Wetherell, RLS 24824, dated 1978
Tied this corner, does not state what he found
No witnesses given

Kenneth L. Ross, PLS 17634, survey dated July & November, 1984
"Fd. USFS Monument" No Witnesses Given

Clinton Cole, PLS 17815, survey dated Sept. 1986, Liber 346, page 315
Tied this corner, does not state what he found, no witnesses given

Kenneth L. Ross, PLS, 17634, survey dated, 10/95 and 3/96, "FD USFS Mon"
No witnesses given
(7) Corner I-6, T.17N., R.15W., North, 2658.11'
(8) Corner J-7, T.17N., R.15W., East, 2642.40'
(9) Corner I-8, T.17N., R.15W., South, 2668.63'

	A	B	C	D	E	F	G	H	I	J	K	L	M
1													
2	6	5	4	3	2	1							
3													
4	7	8	9	10	11	12							
5													
6	18	17	16	15	14	13							
7													
8	19	20	21	22	23	24							
9													
10	30	29	28	27	26	25							
11													
12	31	32	33	34	35	36							
13													

B. Description of corner evidence found and/or method applied in restoring or reestablishing corner:
Corner Common to Sections 14, 15, 22 and 23, T.17N., R.15W.,

Found the 5" square Concrete Monument as described by Griffin above. Witnesses (1) and (2) have been destroyed, Witnesses (3) through (9) are standing and in good condition. I found no other evidence to dispute the location of this corner.

C. Description of monument for corner and accessories established to perpetuate locating the position of the corner:
Corner Common to Sections 14, 15, 22 and 23, T.17N., R.15W.,

I left the 5" square Concrete Monument in place projecting 1.0' above the ground. This corner accepted as a careful and faithful re-establishment of the position of the original corner.

- (3) 10" dock spike, West side of 12" White Oak, S05°E, 24.98'
(4) 10" dock spike, NW side of 14" Maple, S27°W, 9.05'
(5) 10" dock spike, SE side of 6" Beech; N18°W, 19.73'
(6) Set small nail in 4" square X 7" Post, North, 1.6'
(7), (8) and (9) as described by Ross above. (Not checked)

Signed by Theodore H. Weinert Date 10/6/00
Theodore H. Weinert



Surveyor's Michigan License No. 19846

LIBER 5 PAGE 57

Approved by Peer Review Group on 10/5/00
Kenneth L. Ross, County Representative [Signature]