

FEB 08 2000

LAND CORNER RECORDATION CERTIFICATE

Filing Requirement of Act 74, Mich. P.A. 1970


SECTION

For corners in
MASON
(County)

Located In:

Corner Code #

- 1. Public Land Survey T 17N R 15W I-09
- T _____ R _____
- T _____ R _____
- T _____ R _____
- 2. Property Controlling S _____ T _____ R _____
- in Section S _____ T _____ R _____
- 3. Miscellaneous S _____ T _____ R _____
- Property in Sec. S _____ T _____ R _____
- 4. Lot No. _____ Recorded Plat _____
- 5. Private Claims _____

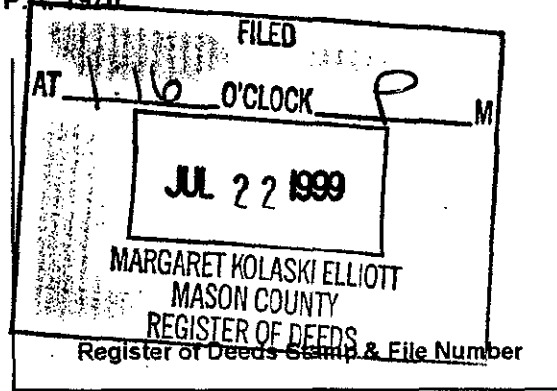

	A	B	C	D	E	F	G	H	I	J	K	L
1												
2	6	5	4	3	2	1						
3												
4	7	8	9	10	11	12						
5												
6	18	17	16	15	14	13						
7												
8	19	20	21	22	23	24						
9												
10	30	29	28	27	26	25						
11												
12	31	32	33	34	35	36						
13												

I, Kenneth L. Ross, in a field survey on May 15, 1999, do hereby certify that under requirements of P.A. 74, Michigan P.A. of 1970, the corner points mentioned in lines 1 and 2 above were in conformance with regulations and rules therefore as required in the current manual of survey instructions of the United States Department of the Interior, Bureau of Land Management or by a decree of a Court of Law and/or that the corner points mentioned in lines 3, 4 and 5 above were in conformance with the rules of the Michigan Board of Land Surveyors or by a Decree of a Court of Law; established, re-established, monumented, re-monumented, recovered, found as expressed below:

NOTE: Not more than 4 corners, all in the same town and range, may be recorded on this certificate.

A. Description of original monument and accessories and/or subsequent restoration:

- I-09 Section Corner for Sections 22, 23, 26 and 27, T17N-R15W.
 - 1838, John Hodgson, G.L.O., (subdivision survey)
Set Post @ 80 chs.
#1 Beech 12" N 15 E 35 lks. (23.10')
#2 Beech 8" S 65 W 33 lks. (21.78')
 - 1963, George Blass, RLS# 5489
Set a 4" x 36" conc. Mon. for the South East Corner for the Plat of P. M. Woods & Rapids.
Liber 3 Pg. 41
Distance North to I-8, 2590.00'
 - 1972, J. Borsfay Mason Co. Road Comm.
Found Conc. Monument set by G. Blass Survey Co.
K-11 land corner record, Liber 2, Page 3
#3 Concrete monument North 33.00'
 - 1977, Robert Griffin, RLS# 13584 (L 2 P 3)
Found Conc. Mon. by Blass in good condition
#4 White Oak 30" N 20 E 121.68'
#5 Power Pole N 82 E 146.63'
#6 Power Pole S 73 W 122.02'
#7 Post 4" x 7' North 33.60'
 - 1998, Kenneth Ross, RLS# 17634, used Blass monument in Surveys B-107, B-199 and 98339sa., record previous witnesses and added,
#8 Cherry 10" S 35 W 47.52'
Distance West to H-9, 2625.58'
Distance South to I-10, 2695.64'

B. Description of corner evidence found and/or method applied in restoring or reestablishing corner:

I-09 Section Corner for Sections 22, 23, 26 and 27, T17N-R15W.
Found Concrete Monument as set by Blass and Described by K.L. Ross, above. Witnesses (1) and (2) have been destroyed. Witnesses (3) thru (8) are standing and in good condition. I found no other evidence to dispute the location of this corner.

C. Description of monument for corner and accessories established to perpetuate locating the position of the corner:

I-09 Section Corner for Sections 22, 23, 26 and 27, T17N-R15W.
I left the 4" Concrete Monument in place 1.0 foot below the gravel surface on the Center-line of Anthony Road. The corner accepted as the best available evidence of the position of the original corner.
(3) Concrete Monument, North, 33.00'
(4) 32" White Oak, existing 60d spike, NW side, N20°E, 121.68'
(5) P.P., existing 16d nail and cap, South side, N82°E, 146.63'
(6) P.P. 60d spike and cap, SE side, S73°W, 122.02'
(7) Post, 4" X 7", 16d nail and cap, West Side, North, 33.60'
(8) Cherry, 10", 60d spike, SE Side, S35°W, 47.52'

Signed by [Signature] Date 7-21-99
Surveyor's Michigan License No. 17634

