

**FEB 08 2000**

**LAND CORNER RECORDATION CERTIFICATE**

Filing Requirement of Act 74, Mich. P.A. 1970

**SECTION**

For corners in Mason (County) Located in: \_\_\_\_\_ Corner Code # \_\_\_\_\_

1. Public Land Survey T 17N R 15W I-10  
 T \_\_\_\_\_ R \_\_\_\_\_  
 T \_\_\_\_\_ R \_\_\_\_\_  
 T \_\_\_\_\_ R \_\_\_\_\_


2. Property Controlling S \_\_\_\_\_ T \_\_\_\_\_ R \_\_\_\_\_  
 in Section S \_\_\_\_\_ T \_\_\_\_\_ R \_\_\_\_\_

3. Miscellaneous S \_\_\_\_\_ T \_\_\_\_\_ R \_\_\_\_\_

Property in Sec. S \_\_\_\_\_ T \_\_\_\_\_ R \_\_\_\_\_

4. Lot No. \_\_\_\_\_, Recorded Plat \_\_\_\_\_

5. Private Claims \_\_\_\_\_

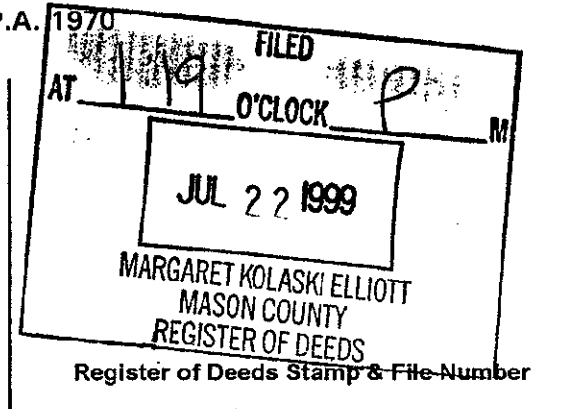

	A	B	C	D	E	F	G	H	I	J	K	L	M
1													
2	6	5	4	3	2	1							
3													
4	7	8	9	10	11	12							
5													
6	18	17	16	15	14	13							
7													
8	19	20	21	22	23	24							
9													
10	30	29	28	27	26	25							
11													
12	31	32	33	34	35	36							
13													

I, Kenneth L. Ross, in a field survey on May 22, 1999, do hereby certify that under requirements of P.A. 74, Michigan P.A. of 1970, the corner points mentioned in lines 1 and 2 above were in conformance with regulations and rules therefore as required in the current manual of survey instructions of the United States Department of the Interior, Bureau of Land Management or by a decree of a Court of Law and/or that the corner points mentioned in lines 3, 4 and 5 above were in conformance with the rules of the Michigan Board of Land Surveyors or by a Decree of a Court of Law, established, re-established, monumented, re-monumented, recovered, found as expressed below:

**NOTE: Not more than 4 corners, all in the same town and range, may be recorded on this certificate.**

**A. Description of original monument and accessories and/or subsequent restoration:**

- I-10, Corner common to Sections 26 and 27, T.17N., R.15W., April, 1976, Act 132  
 GLO, John Hodgson K.L. Ross, "ex. 3/4" pipe"  
 4<sup>th</sup> quarter, 1838 Distance South to I-11, 2644.63'  
 Set quarter sec. post Distance North to I-9, 2696.05'  
 (1) Pine, 18", S87°E, 29 links(19.14') Witnesses (6) to (8) given.  
 (2) Pine, 12", N63°W, 9 links(5.94')
- May, 1963, File, B-56 October, 1976, Act 132  
 K.B. Stephens, "Set 3/4" iron pipe" K.L. Ross, "ex. 3/4" pipe"  
 (3) Oak, 16", SW, 72.2' Witnesses (6) to (8) given  
 (4) Oak, 18", NW, 49.6'  
 (5) Oak, 24", NE, 49.2'
- October, 1975, Act 132 October, 1985, Act 132  
 K.L. Ross, "Fd. 3/4" pipe" K.L. Ross, "ex. 3/4" pipe"  
 (6) Black Oak, 30", N10°E, 48.74' Witnesses (6) to (8) given  
 (7) Twin 20" & 10", Black Oak, N80°W Distance South to I-11, 2644.71'  
 49.75'  
 (8) In Center Line of Road to South & June, 1990, Act 132  
 and road to east Projected K.L. Ross, "ex. 3/4" pipe"  
 Witnesses (6) to (8) given

December, 1993, Act 132  
 K.L. Ross, "1/2" iron rod  
 No Witnesses Given  
 Distance South to I-11, 2644.78'


October, 1998, Act 132  
 K.L. Ross, "ex. 3/4" iron rod"  
 (6) 36" Black Oak, N23°E, 48.74'  
 (9) Cherry, 9", S59°E, 75.75'  
 (10) Black Oak, 24", N66°W, 49.69'  
 (11) White Oak, 22", S69°W, 57.65'

**B. Description of corner evidence found and/or method applied in restoring or reestablishing corner:**

I-10, Corner common to Sections 26 and 27, T.17N., R.15W  
 Found 3/4" X 18" re-bar on the center-line of Taylor Road extended and on the South edge of a drive to the West, about 30 feet South of the center-line of road to east projected 1.0' below the ground surface. Witnesses (1) thru (5) and (7) have been destroyed. Witnesses (6), (9), (10) and (11) are standing and in good condition. I found no other evidence to dispute the location of this corner.

**C. Description of monument for corner and accessories established to perpetuate locating the position of the corner:**

I-10, Corner common to Sections 26 and 27, T.17N., R.15W.,  
 I replaced the 3/4" X 18" re-bar with a standard 3" Cast Iron Harrison Monument, stamped "Mason County Monument", 1.0' below the ground surface. This corner accepted as the best available evidence of the position of the original corner.  
 (6) Black Oak, 36", existing 60d spike, East side, N23°E, 48.74'  
 (9) Cherry, 9", existing 60d spike, SW side, S59°E, 75.75'  
 (10) Black oak, 24", existing 60d spike, South side, N66°W, 49.69'  
 (11) White oak, 22", existing 60d spike, NW side, S69°W, 57.65'

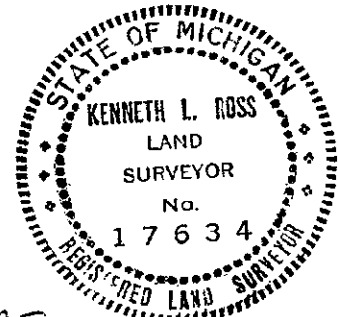

Signed by [Signature] Date 7-21-99

Surveyor's Michigan License No. 17634

Peer Group Reviewed and Approved  
 Date: 7-14-99  
[Signature]  
 Kenneth L. Ross  
 Mason County, Michigan

LIBER

4 PAGE 254