

**SURVEY & REMONUMENTATION**

**JAN 23 2001**


**SECTION**

**LAND CORNER RECORDATION CERTIFICATE**

Filing Requirement of Act 74, Mich. P.A. 1970

For corners In: Located In: Corner Code #  
Mason County

- 1. Public Land Survey T 17N R 15W J-11  
T R  
T R  
T R
- 2. Property Controlling S T R  
in Section S T R
- 3. Miscellaneous S T R
- Property in Sec. S T R

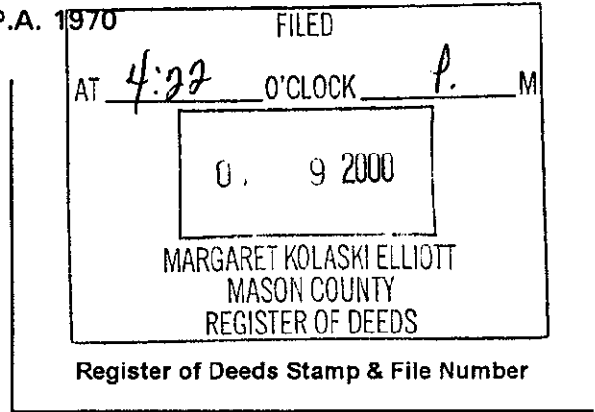

- 4. Lot No. \_\_\_\_\_, Recorded Plat \_\_\_\_\_
- 5. Private Claims \_\_\_\_\_

Theodore H. Weinert, in a field survey on September 3, 2000, Do hereby certify that under requirements of P.A. 74, Michigan P.A. of 1970, the corner points mentioned in lines 1 and 2 above were in conformance with regulations and rules therefore as required in the current manual of survey instructions of the United States Department of the Interior, Bureau of Land Management or by a decree of a Court of Law and/or that the corner points mentioned in lines 3, 4 and 5 above were in conformance with the rules of the Michigan Board of Land Surveyors or by a Decree of a Court of Law; established, re-established, monumented, re-monumented, recovered, found as expressed below:

NOTE: Not more than 4 corners, all in the same town and range, may be recorded on this certificate.

A. Description of original monument and accessories and/or subsequent restoration:  
Corner Common to Sections 26 and 35, T.17N., R.15W.,

- Original Government Survey Completed by Hodgson, 1838
- Survey by Kenneth L. Ross, PLS, 17634, 10/8/76
- Tied this corner does not state what he found
- No witnesses given
- (6) Corner I-11, T.17N., R.15W., West, 2648.80'
- (1) Pine, 12", N30°E, 19 links (12.54')
- (2) Pine, 24", S73°W, 13 links (8.58')
- 'Set quarter section post'
- Survey by Kenneth L. Ross, PLS 17634, 10/20/75
- 'Set 1" pipe at intersection of East-West Fence and fence to North'
- (3) Twin Red Oak, 12", S80°E, 18.34'
- (4) Triple Red Oak, 10", S30°E, 15.24'
- (5) Maple, 10", N20°W, 10.78'
- (6) Corner I-11, T.17N., R.15W., West, 2648.80'
- (7) Corner K-11, T.17N., R.15W., East, 2611.66'

3. Description of corner evidence found and/or method applied in restoring or reestablishing corner:  
Corner Common to Sections 26 and 35, T.17N., R.15W.,


Found 1" X 18" Capped #17634 Iron Pipe as described by K. Ross above. Witnesses (1) and (2) have been destroyed. Witnesses (3) through (7) are in good condition. I found no other evidence to dispute the location of this corner.

3. Description of monument for corner and accessories established to perpetuate locating the position of the corner:  
Corner Common to Sections 26 and 35, T.17N., R.15W.,

- replaced the 1" X 18" capped iron pipe in the exact location with a 3" X 30" Standard Cast Iron Monument stamped "Mason County Monument", 19846", flush with the ground. This corner accepted as a careful and faithful re-establishment of the original corner.
- 3) Existing 60d spike South side of 13" twin Red Oak, S80°E, 18.34'
- 4) Existing 60d spike, NE side of 11" triple Red Oak, S30°E, 15.24'
- 5) Existing 60d spike, NE side of 12" Maple, N20°W, 10.78'
- 6) Corner I-11, T.17N., R.15W., West, 2648.80' (Ross above, not checked)
- 7) Corner K-11, T.17N., R.15W., East, 2611.66' (Ross above, not checked)
- Old fence line East and West and trace of fence to North.

1	A	B	C	D	E	F	G	H	I	J	K	L	M
2		6	5	4	3	2	1						
3													
4		7	8	9	10	11	12						
5													
6		18	17	16	15	14	13						
7													
8		19	20	21	22	23	24						
9													
10		30	29	28	27	26	25						
11													
12		31	32	33	34	35	36						
13													

signed by Theodore H. Weinert Date 10/6/00  
Theodore H. Weinert

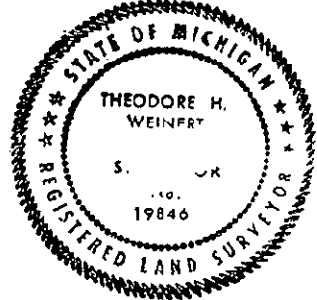

Surveyor's Michigan License No. 19846  
LIBER 5 PAGE 53  
Approved by Peer Review Group on 10/5/00  
Kenneth L. Ross, County Representative