

SURVEY & REMONUMENTATION

JAN 23 2001


LAND CORNER RECORDATION CERTIFICATE

SECTION

Filing Requirement of Act 74, Mich. P.A. 1970

For corners In: Located In: Corner Code #
 Mason County

Public Land Survey T 17N R 15W K-1
 T _____ R _____
 T _____ R _____
 T _____ R _____
 1. Property Controlling S _____ T _____ R _____
 in Section S _____ T _____ R _____
 2. Miscellaneous S _____ T _____ R _____
 Property in Sec. S _____ T _____ R _____

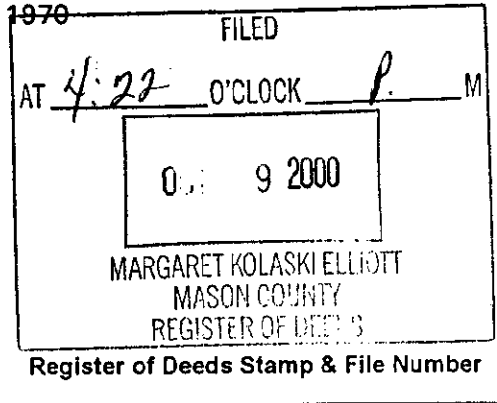

1. Lot No. _____, Recorded Plat _____
 2. Private Claims _____

Theodore H. Weinert, in a field survey on September 3, 2000, Do hereby certify that under requirements of P.A. 74, Michigan P.A. of 1970, the corner points mentioned in lines 1 and 2 above were in conformance with regulations and rules therefore as required in the current manual of survey instructions of the United States Department of the Interior, Bureau of Land Management or by a decree of a Court of Law and/or that the corner points mentioned in lines 3, 4 and 5 above were in conformance with the rules of the Michigan Board of Land Surveyors or by a Decree of a Court of Law; established, re-established, monumented, re-monumented, discovered, found as expressed below:

	A	B	C	D	E	F	G	H	I	J	K	L	M
1													
2	6	5	4	3	2	1							
3													
4	7	8	9	10	11	12							
5													
6	18	17	16	15	14	13							
7													
8	19	20	21	22	23	24							
9													
10	30	29	28	27	26	25							
11													
12	31	32	33	34	35	36							
13													

NOTE: Not more than 4 corners, all in the same town and range, may be recorded on this certificate.

1. Description of original monument and accessories and/or subsequent restoration:
Corner common to Sections 1 and 2, T.17N., R.15W., and Sections 35 and 36, T.18N., R.15W.,

Original Government Survey by Mullet and Brookfield, 1837 States N.bdry, 6 links (3.96') East of Post" 1) Pine, 8", S40°E, 26 links (17.16') 2) Pine, 10", N73°W, 24 links (15.84')	R.A. Griffin, RLS #13584 LCRC, Liber 2, page 81, dated 10/14/80 States " This corner was re-established by proportional measurement and on a straight line between controlling corners." Set 5" X 36" Concrete Monument with brass cap (3) Corner J-1, T.17N., R.15W., N89° 30' 34"W, 2646.15' (4) Corner K-2, T.17N., R.15W., S00° 27' 10"E, 2706.67' (5) Pine Post, 4", East 29.14' (6) B. Oak, 6", N48°W, 105.52'
---	---

2. Description of corner evidence found and/or method applied in restoring or reestablishing corner:
Corner common to Sections 1 and 2, T.17N., R.15W., and Sections 35 and 36, T.18N., R.15W.,


found the 5" square concrete monument as set by Griffin above in good condition, 1.0' below the surface of Masten Road. Witnesses (5) and (6) are standing and in good condition. Witnesses (1) and (2) have been destroyed. Witnesses (3) and (4) were not checked as I have no reason to dispute them. I found no other evidence to dispute the location of this corner.

3. Description of monument for corner and accessories established to perpetuate locating the position of the corner:
Corner common to Sections 1 and 2, T.17N., R.15W., and Sections 35 and 36, T.18N., R.15W.,

left the 5" square concrete monument in place 1.0' below the surface of Masten Road and 3' East of the center-line of Masten Road. This corner accepted as a careful and faithful re-establishment of the position of the original corner.

- 5) Existing Nail and Lemon brass cap PLS #15384, South side of 4" square USFS Post, East, 29.14'
- 6) 10" Dock Spike, North side of " Black Oak, N48°W, 105.52'
- 7) 10" Dock Spike, SE side of 10" Black Oak, N57°E, 50.22'
- 8) 10" Dock Spike, SW side of 10" White Oak, S60°E, 83.56'
- 9) 10" Dock spike, South side of 8" Black Oak, N63°W, 130.20'

Signed by Theodore H. Weinert Date 10/6/00
 Theodore H. Weinert

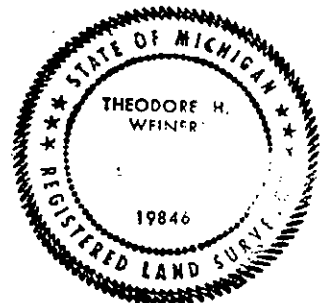

Surveyor's Michigan License No. 19846

Approved by Peer Review Group on 10/15/00
 Kenneth L. Ross, County Representative