


**JAN 23 2001**

**SECTION LAND CORNER RECORDATION CERTIFICATE**

Filing Requirement of Act 74, Mich. P.A. 1970

For corners In: Located In: Corner Code #  
Mason County

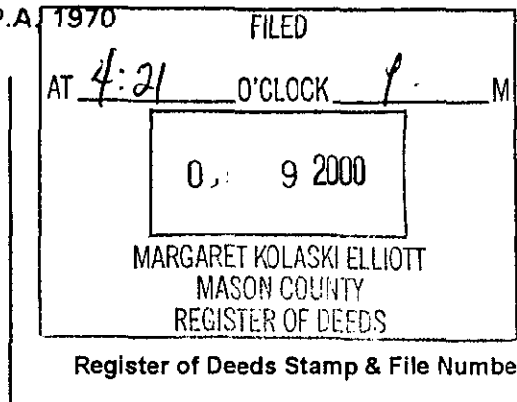

- 1. Public Land Survey T 17N R 15W K-2
- 2. Property Controlling in Section S T R
- 3. Miscellaneous S T R
- Property in Sec. S T R

- 4. Lot No. \_\_\_\_\_, Recorded Plat \_\_\_\_\_
- 5. Private Claims \_\_\_\_\_

	A	B	C	D	E	F	G	H	I	J	K	L	M
1													
2	6	5	4	3	2	1							
3													
4	7	8	9	10	11	12							
5													
6	18	17	16	15	14	13							
7													
8	19	20	21	22	23	24							
9													
10	30	29	28	27	26	25							
11													
12	31	32	33	34	35	36							
13													

I, Theodore H. Weinert, in a field survey on September 3, 2000, Do hereby certify that under requirements of P.A. 74, Michigan P.A. of 1970, the corner points mentioned in lines 1 and 2 above were in conformance with regulations and rules therefore as required in the current manual of survey instructions of the United States Department of the Interior, Bureau of Land Management or by a decree of a Court of Law and/or that the corner points mentioned in lines 3, 4 and 5 above were in conformance with the rules of the Michigan Board of Land Surveyors or by a Decree of a Court of Law; established, re-established, monumented, re-monumented, recovered, found as expressed below:

NOTE: Not more than 4 corners, all in the same town and range, may be recorded on this certificate.

A. Description of original monument and accessories and/or subsequent restoration:  
Corner Common to Sections 1 and 2, T.17N., R.15W.,

- Original Government Survey by Hodgson, 1838 "Set Quarter Section Post"
- (1) Pine, 8", N30°W, 18 links (11.88')
- (2) Pine, 8", S45°E, 25 links (16.50')
- R.A. Griffin, RLS #13584 LCRC, Liber 2, Page 81, dated 10/14/80 States " Corner was recovered by Proportional measurement and on a straight line between controlling corners." Set 5" X 36" conc. Monument with Brass Cap
- (3) Corner K-1, T.17N., R.15W., N 00° 27' 10" W, 2706.67'
- (4) S 1/16<sup>th</sup> Corner to Sections 1 & 2, S00° 27' 10" E, 1310.74'
- (5) Pine Post, 5" N88°W., 35.75'
- (6) B. Oak, 8", N75°W, 64.86'

Robert L. Wetherell, RLS #24624 Recorded Survey, Liber 285, page 239 Dated 10/24/84, Tied this Corner, does not state what he found, no witnesses given.  
(7) Corner K-3, T.17N., R.15W., South, 2622.30'


B. Description of corner evidence found and/or method applied in restoring or reestablishing corner:  
Corner Common to Sections 1 and 2, T.17N., R.15W.,

I found the 5" square concrete monument as described by Griffin above in good condition, 1.0' below the surface of the road and 4' East of the center-line of Masten Road. Witness (6) is standing and in good condition. Witnesses (1), (2) and (5) have been destroyed. Witnesses (3), (4) and (7) were not checked as I have no reason to dispute their distances. I found no other evidence to dispute the location of this corner.

C. Description of monument for corner and accessories established to perpetuate locating the position of the corner:  
Corner Common to Sections 1 and 2, T.17N., R.15W.,

I left the 5" square concrete monument in place 1.0' below the surface of Masten Road and 3' East of the center-line of Masten Road This corner accepted as a careful and faithful re-establishment of the position of the original corner.

- (6) Existing 10" Dock Spike, SW side of 10" Black Oak, N75°W, 64.86'
- (8) Set 60d spike South side of Treated 5" round post, N88°W, 35.85'
- (9) Set 60d spike SE side of 8" Black Oak, S80°W, 37.10'
- (10) Set 60d spike, NE side of 15" Black Oak, S28°E, 63.49'
- (11) Existing 10" Dock Spike, SE side of 10" Black Oak, N66°E, 67.88'
- USFS dirt trail bears NE'ly from this corner. 5' East of the center-line of Masten Road and 1.0' below the surface.

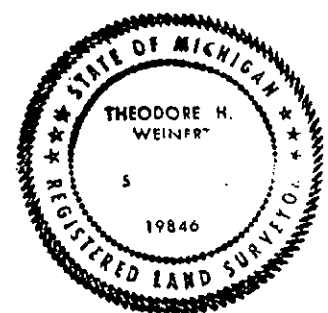

Signed by Theodore H. Weinert Date 10/6/00  
Theodore H. Weinert

Surveyor's Michigan License No. 19846

Approved by Peer Review Group on 10/5/00  
Kenneth L. Ross, County Representative [Signature]

**LIBER 5 PAGE 51**