

SURVEY & REMONUMENTATION

JAN 23 2001


LAND CORNER RECORDATION CERTIFICATE

SECTION

Filing Requirement of Act 74, Mich. P.A., 1970

For corners In: Located In: Corner Code #
Mason County

- | | | | |
|---------------------------------------|-------------------------|-------|-------|
| 1. Public Land Survey | T 17N R 15W | K-6 | |
| | T _____ R _____ | _____ | _____ |
| | T _____ R _____ | _____ | _____ |
| | T _____ R _____ | _____ | _____ |
| 2. Property Controlling in Section | S _____ T _____ R _____ | _____ | _____ |
| | S _____ T _____ R _____ | _____ | _____ |
| 3. Miscellaneous | S _____ T _____ R _____ | _____ | _____ |
| Property in Sec. | S _____ T _____ R _____ | _____ | _____ |
| 4. Lot No. _____, Recorded Plat _____ | | | |
| 5. Private Claims _____ | | | |

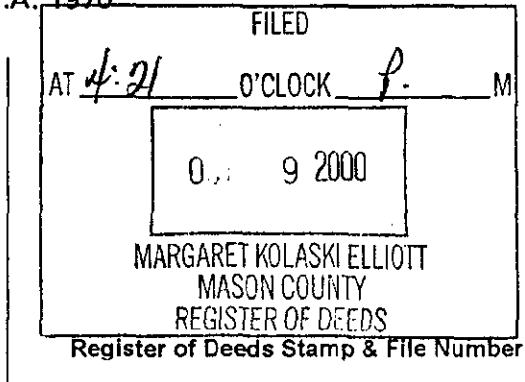

	A	B	C	D	E	F	G	H	I	J	K	L	M
1													
2	6	5	4	3	2	1							
3													
4	7	8	9	10	11	12							
5													
6	18	17	16	15	14	13							
7													
8	19	20	21	22	23	24							
9													
10	30	29	28	27	26	25							
11													
12	31	32	33	34	35	36							
13													

I, Theodore H. Weinert, in a field survey on September 3, 2000, Do hereby certify that under requirements of P.A. 74, Michigan P.A. of 1970, the corner points mentioned in lines 1 and 2 above were in conformance with regulations and rules therefore as required in the current manual of survey instructions of the United States Department of the Interior, Bureau of Land Management or by a decree of a Court of Law and/or that the corner points mentioned in lines 3, 4 and 5 above were in conformance with the rules of the Michigan Board of Land Surveyors or by a Decree of a Court of Law; established, re-established, monumented, re-monumented, recovered, found as expressed below:

NOTE: Not more than 4 corners, all in the same town and range, may be recorded on this certificate.

A. Description of original monument and accessories and/or subsequent restoration:

Corner common to Sections 13 and 14, T.17N., R.15W.,

Original Government Survey by Hodgson, 1838
"Set Quarter Section Post"
(1) Hemlock, 8", N11°W, 9 links, (5.94')
(2) Hemlock, 10", S13°E, 33 links, (21.78')

Mason County Road Commission Record
1957, States "1" Iron
(3) Elm, 12", NW, 54.7'
(4) Fence Corner, West, 29.1'
(5) P.P., NE, 33.7'
(6) Fence Corner, East, 28.1'

Survey by Kenneth L. Ross, PLS #17634
Dated 10/31/95, Does not state what he found.
(7) P.P. w/Leemon Tag #15384, N82° 32' 14"E, 35.15'
(8) Cherry, 6", N86° 31' 11" W, 61.39'
(9) S. End rail of bridge, N01° 12' 49", W, 320.23'
(10) S. End rail of bridge, N03° 15' 51" W, 320.74'
(11) Ash, 10", S04° 29' 06"E, 359.19'

B. Description of corner evidence found and/or method applied in restoring or reestablishing corner:

Corner common to Sections 13 and 14, T.17N., R.15W.,

Found a 1/2" by 18" re-rod in a Monument Box on the center-line of Masten Road. Witnesses (7) Thru (11) are standing and in good condition. Witnesses (1) thru (6) have been destroyed. I found no other evidence to dispute the location of this corner.


C. Description of monument for corner and accessories established to perpetuate locating the position of the corner:

Corner common to Sections 13 and 14, T.17N., R.15W.,

I replaced the 1/2" X 18" re-rod in the exact location with a 5/8" X 24" re-rod and standard 2 1/2" aluminum disk stamped "Mason County Monument", 19846
This corner accepted as the best available evidence to the position of the original corner.

- (7) P.P. with Leemon Tag PLS #15384, N82 E, 35.15'
- (8) Cherry, 7", N88 W, 61.39'
- (9) S. End rail of bridge, N01W, 320.23'
- (10) S end rail of bridge, N03W, 320.74'
- (11) Ash, 11", S04°E, 359.19'
- (12) Distance South to K-7, T.17N., R.15W., 2630.04' (Ross above, not checked)

Signed by Theodore H. Weinert Date 10/6/00
Theodore H. Weinert

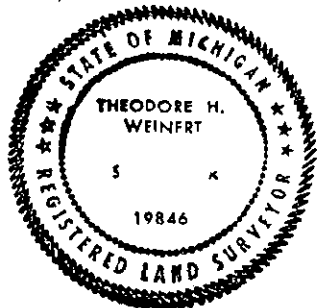

Surveyor's Michigan License No. 19846
Approved by Peer Review Group on 10/6/00
Kenneth L. Ross, County Representative [Signature]

LIBER 5 PAGE 50