

**SURVEY & REMONUMENTATION**

**JAN 23 2001**


**LAND CORNER RECORDATION CERTIFICATE**

**SECTION**

Filing Requirement of Act 74, Mich. P.A. 1970

For corners In: Located In: Corner Code #  
Mason County

- 1. Public Land Survey T 17N R 15W \_\_\_\_\_ K-7  
T \_\_\_\_\_ R \_\_\_\_\_  
T \_\_\_\_\_ R \_\_\_\_\_  
T \_\_\_\_\_ R \_\_\_\_\_
- 2. Property Controlling in Section S \_\_\_\_\_ T \_\_\_\_\_ R \_\_\_\_\_  
S \_\_\_\_\_ T \_\_\_\_\_ R \_\_\_\_\_
- 3. Miscellaneous S \_\_\_\_\_ T \_\_\_\_\_ R \_\_\_\_\_
- Property in Sec. S \_\_\_\_\_ T \_\_\_\_\_ R \_\_\_\_\_

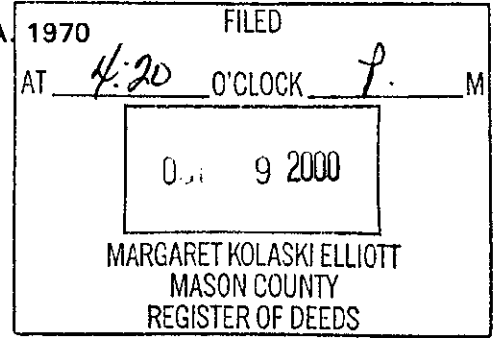

Register of Deeds Stamp & File Number

- 4. Lot No. \_\_\_\_\_; Recorded Plat \_\_\_\_\_
- 5. Private Claims \_\_\_\_\_

I, Theodore H. Weinert, in a field survey on September 3, 2000, Do hereby certify that under requirements of P.A. 74, Michigan P.A. of 1970, the corner points mentioned in lines 1 and 2 above were in conformance with regulations and rules therefore as required in the current manual of survey instructions of the United States Department of the Interior, Bureau of Land Management or by a decree of a Court of Law and/or that the corner points mentioned in lines 3, 4 and 5 above were in conformance with the rules of the Michigan Board of Land Surveyors or by a Decree of a Court of Law; established, re-established, monumented, re-monumented, recovered, found as expressed below:

1	A	B	C	D	E	F	G	H	I	J	K	L	M
2		6	5	4	3	2	1						
3													
4		7	8	9	10	11	12						
5													
6		18	17	16	15	14	13						
7													
8		19	20	21	22	23	24						
9													
10		30	29	28	27	26	25						
11													
12		31	32	33	34	35	36						
13													

NOTE: Not more than 4 corners, all in the same town and range, may be recorded on this certificate.

A. Description of original monument and accessories and/or subsequent restoration:  
Corner Common To Sections 13, 14, 23 & 24, T. 17N., R. 15W.,

- Original Government Survey by Hodgson, 1838  
(1) Maple, 18", N57°E, 60 links (39.60')  
(2) Willow, 4", S20°E, 12 links (7.92')
- Mason County Road Commission Record 1957, "Pipe"  
T.P. NW, 59.4'  
(6) P.P. NE, 32.4'  
(7) Elm, 6", SW, 62.4'
- Book 1, Pages 12 & 13, Survey by Peter Eastman 8/15/1883 does not state what he found  
No Witnesses Given  
(3) Corner L-7, T. 17N., R. 15W., East, 2645.28'  
(4) Corner K-8, T. 17N., R. 15W., South, 2636.04'
- Survey by Kenneth L. Ross, 10/31/95  
RLS # 17634 "1" Iron"  
(8) Elm, 14", N57° 43' W, 71.89'  
(9) Cen Tel Box, N28° 54' W, 63.14'  
(10) P.P. N77° 19' E, 33.08' (possible # 6)  
(11) Corner K-6, T. 17N., R. 15W., North 2630.04'  
(12) Corner J-7, T. 17N., R. 15W., West, 2627.66'
- Survey by Kenneth L. Ross, RLS # 17634  
3/7/96 "1" Iron"  
Witnesses, (8), (9) and (10) given


B. Description of corner evidence found and/or method applied in restoring or reestablishing corner:  
Corner Common To Sections 13, 14, 23 & 24, T. 17N., R. 15W.,

Found a 1" Solid Iron Bar in a Monument Box on the Center/line of Masten Road. Witnesses (1) thru (7) have been destroyed. Witnesses (8) thru (10) are standing and in good condition. I did not check witnesses (11) and (12) as I have no reason to dispute their distances. I found no other evidence to dispute the location of this corner.

C. Description of monument for corner and accessories established to perpetuate locating the position of the corner:  
Corner Common To Sections 13, 14, 23 & 24, T. 17N., R. 15W.,

- I left the 1" solid Iron bar in place inside the Monument Box and accepted this as a careful and faithful re-establishment of the position of the original corner.
- (8) Existing 60d spike, SW side of 16" Elm, N57° 43' W, 71.89'
- (9) Top center of Cen Tel Box, N28° 54' W, 63.14'
- (10) Existing 60d spike, North Side of P.P. N77° 19' E, 33.08'
- (11) Corner K-6, T. 17N., R. 15W., North, 2630.04' (Ross above, not checked)
- (12) Corner J-7, T. 17N., R. 15W., West, 2627.66' (Ross above, not checked)

Signed by Theodore H. Weinert Date 10/6/00  
Theodore H. Weinert

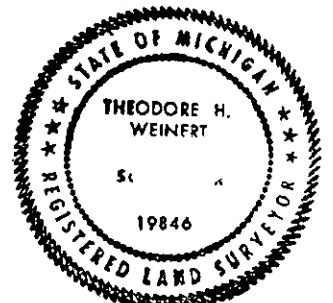

Surveyor's Michigan License No. 19846

**LIBER 5 PAGE 49**

Approved by Peer Review Group on 10/15/00  
Kenneth L. Ross, County Representative