

SURVEY & REMONUMENTATION

JAN 28 2001

LAND CORNER RECORDATION CERTIFICATE


Filing Requirement of Act 74, Mich. P.A. 1970

SECTION

For corners In: Located In: Corner Code #

Mason County

1. Public Land Survey T 17N R 15W K-9
 T _____ R _____
 T _____ R _____
 T _____ R _____
2. Property Controlling in Section S _____ T _____ R _____
 S _____ T _____ R _____
3. Miscellaneous S _____ T _____ R _____
- Property in Sec. S _____ T _____ R _____
4. Lot No. _____, Recorded Plat _____
5. Private Claims _____

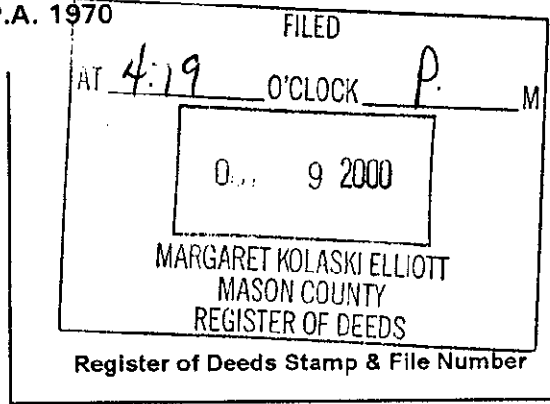

	A	B	C	D	E	F	G	H	I	J	K	L	M
1													
2	6	5	4	3	2	1							
3													
4	7	8	9	10	11	12							
5													
6	18	17	16	15	14	13							
7													
8	19	20	21	22	23	24							
9													
10	30	29	28	27	26	25							
11													
12	31	32	33	34	35	36							
13													

I, Theodore H. Weinert, in a field survey on September 3, 2000, Do hereby certify that under requirements of P.A. 74, Michigan P.A. of 1970, the corner points mentioned in lines 1 and 2 above were in conformance with regulations and rules therefore as required in the current manual of survey instructions of the United States Department of the Interior, Bureau of Land Management or by a decree of a Court of Law and/or that the corner points mentioned in lines 3, 4 and 5 above were in conformance with the rules of the Michigan Board of Land Surveyors or by a Decree of a Court of Law; established, re-established, monumented, re-monumented, recovered, found as expressed below:

NOTE: Not more than 4 corners, all in the same town and range, may be recorded on this certificate.

A. Description of original monument and accessories and/or subsequent restoration:
Corner Common to Sections 23, 24, 25 and 26, T.17N., R.15W.,

- | | | |
|---|---|---|
| <p>Original Government Survey by Hodgson, 1838
 "Set post"
 (1) Beech, 6", N48°E, 25 links (16.50')
 (2) Beech, 8", S52°W, 29 links (19.14')</p> <p>Book 1, Pages 12 & 13, Survey by Peter Eastman August, 1883 "Found old witnesses"
 No new witnesses given
 (3) Corner K-8, T.17N., R.15W., North, 2638.02'
 (4) Corner L-9., T.17N., R.15W., East, 2537.70'</p> | <p>Book 1, page 219, Survey by W. Metcalf November, 1889, "Found Long Square Stone, 16" long and 5" square with small stones around it"
 (4) Corner L-9, East, 2537.04'
 (5) Corner Fence Post, N 47° 30' W, 64 links (42.24')
 (6) Corner Fence Post, S 44°W, 48 links (31.68')
 (7) Corner K-10, T.17N., R.15W., South, 2732.04'</p> <p>Book 2, Page 316 and 317, survey by R. E. Lunde 1934 "Found Iron Pin in Stones"
 (7) Corner K-10, South, 2749.10'
 (8) Elm 24", S37°W, 42.0'
 (9) Elm, 20", N16° 45' W, 133.50'</p> | <p>Survey by Kenneth L. Ross, PLS 17634 Liber 1, Page 376 tied this corner does not state what he found, no new witnesses given.
 (7), Corner K-10, South 2745.04'
 (10) Corner J-9, T.17N., R.15W., West, 2621.05'
 (date 10/20/75)
 Survey by Robert L. Wetherell, PLS 24624 "iron pin in Mon Box" No Witnesses Given
 (4), Corner L-9, East, 2546.05'</p> <p>Survey by Kenneth L. Ross, PLS 17634 March, 1996, "1" sq bolt in Mon Box" No new witnesses given.
 (3) Corner K-8, North, 2633.69'
 (10) Corner J-9, West, 2620.95'</p> |
|---|---|---|


B. Description of corner evidence found and/or method applied in restoring or reestablishing corner:
Corner Common to Sections 23, 24, 25 and 26, T.17N., R.15W.,

Found a 12" long bolt spike in Monument Box, 1 foot west of the center-line of Masten Road. Upon removal of the bolt spike I found it to be a riser to a large stone about 15 inches below the surface of the road which I believe to be the stone described by Metcalf above. Witnesses (1), (2), (5), (6), (8) and (9) have been destroyed. Witnesses (3), (4), (7) and (10) are in and in good condition. I found no other evidence to dispute the location of this corner.

C. Description of monument for corner and accessories established to perpetuate locating the position of the corner:
Corner Common to Sections 23, 24, 25 and 26, T.17N., R.15W.,

- I replaced the 12" long bolt spike in the exact location with a 5/8" X 15" re-rod (cut off due to stone) with the standard 2 1/2" aluminum disk stamped "Mason County Monument, 19846" inside the Monument Box. This corner accepted as careful and faithful re-establishment of the original corner.
- (11) Set 60d spike in NW side of P.P. N54°E, 57.88'
 (12) Set 60d spike 5' above ground in SE side of 14" Elm, S69°W, 68.21'
 (13) Center Top of Telephone Box, S49°E, 52.95'
 (7) Corner K-10, South, 2745.08' (Measured EDM 9/2/00)
 (10) Corner J-9, West, 2621.03' (Measured EDM 9/2/00)

Signed by Theodore H. Weinert Date 10/16/00
 Theodore H. Weinert

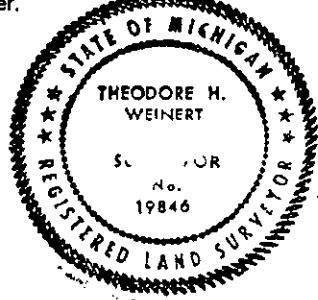

Surveyor's Michigan License No. 19846
 Approved by Peer Review Group on 10/15/00
 Kenneth L. Ross, County Representative

LIBER 5 PAGE 47