

SEP 30 1993

COMMISSION

LAND CORNER RECORDATION CERTIFICATE

FILING REQUIREMENT OF ACT 74, MICH. P.A.1970

FOR CORNERS OF--	LOCATED IN--	CORNER CODE NUMBER
1. PUBLIC LAND SURVEY _____	T. _____ 17N N. _____ 15W E. _____ S., R. _____ W.	K12
2. PROPERTY CONTROLLING IN SECTION _____	, T. _____ N. _____ E. _____ S., R. _____ W.	
3. MISCELLANEOUS PROPERTY IN SECTION _____	, T. _____ N. _____ E. _____ S., R. _____ W.	
4. LOT NO. _____, RECORDED PLAT _____		
5. PRIVATE CLAIMS _____		

FILED

AT 2 O'CLOCK P M

SEP 23 1993

MARY GOLDEN KOLASKI
MASON COUNTY REGISTER OF DEEDS
REGISTER OF DEEDS STAMP AND FILING NUMBER

I, Patrick R. Leemon do hereby certify that under requirements of P.A. 74, Michigan P.A. of 1970, the corner points mentioned in lines 1 and 2 above (identified with circles on index code diagram - over) were, in a field survey on August 23 1993, established, re-established, monumented, re-monumented, recovered or restored as expressed below and in conformance with regulations and rules therefore as required in the current manual of survey instructions of the United States Department of the Interior, Bureau of Land Management or by a decree of a court of law. Furthermore, that the corner points mentioned in lines 3, 4 and 5 above were, in a field survey on _____ 19____, found, recovered, restored, established or re-established as expressed below and in conformance with the rules of the Michigan State Board of Registration for Land Surveyors or, by a Decree of a Court of law:

A. Description of original monument and accessories and/or subsequent restoration:

1/4 corner common to sections 35 and 36 of T17N R15W

1838 survey by John Hodgson
Set Wood Post
Pine 12 S11W 31 links
Pine 10 N65E 10 links

1988 survey by S. Barnett
Monu. Iron Pipe in monu. box
NW 36 N00-35-54E 2693.35 feet
SW 36 S00-35-51E 2602.36 feet

1972 survey by Robert A. Griffin
Set a 5" sq. x 36" long conc. monu. w/brass cap off fence to East and on line between the NW & SW cor
P. Post 4"x7" East 33.20 feet
W. Oak 5 N88W 67.96 feet
W. Oak 6 N42W 94.44 feet
NW 36 North 2593.76 feet
SW 36 South 2602.66 feet

1934 survey by Robert Lunde
Monument is Iron Pin & Stones
P. Stp N33W 53.7 feet
P. Stp N29-45E 30.0 feet
SW 36 South 2608.6 feet

B. Description of corner evidence found and/or method applied in restoring or re-establishing corner:
I found the monument box called for by Barnett. I did not find an Iron Pipe. I found a 1" square by 14" long spike just like the one I recovered at the NW 36. I did not dig down 48" to recover the brass cap by Griffin because the distances checked so well with Barnett and it also checked with the W. Oak N88W 67.96 feet. All other witnesses were destroyed when the county rebuilt this road prior to 1988. This corner is 0.5' east of the centerline of the N-S pavement. Liber 1 Page 225 and 245 by Griffin documents the history of this corner. This monument is accepted as a careful and faithful perpetuation of the position of the original corner.

C. Description of monument for corner and accessories established to perpetuate locating the position of the corner:

1/4 corner common to sections 35 and 36 of T17N R15W

Monu. 5" sq. by 36" long concrete monu. with 3" brass disk was left in place. I raised it to the surface with a 5/8"x24" rebar with stamped aluminum cap set in the monument box.

Witnesses:
P. Pole N78E 30.90'
P. Post 4"x7" East 33.22'
B. Oak 14 N31E 134.57'
W. Oak 12 West 67.96'
B. Oak 8 S50W 62.29'

Peer Group Reviewed and Approved
Date: 9-16-93
Kenneth L. Ross
Mason County Surveyor


SIGNED BY Patrick R. Leemon DATE September 9, 1993

SURVEYOR'S MICHIGAN REGISTRATION NO. 31595

FOR STATE AND UNITED STATES AGENCIES:

SIGNED BY _____ DATE _____
CHIEF OF SURVEY PARTY

APPROVED AND SIGNED BY _____ DATE _____
MICHIGAN REGISTERED LAND SURVEYOR

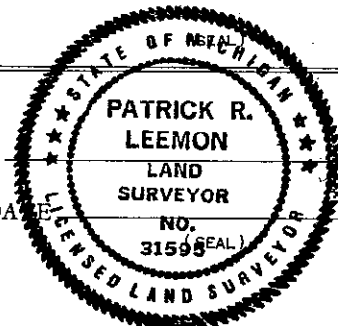

LIBER 3 PAGE 120

SURVEYOR'S MICHIGAN REGISTRATION NO. _____