


JAN 23 2001

SECTION

LAND CORNER RECORDATION CERTIFICATE

Filing Requirement of Act 74, Mich. P.A. 1970

For corners In: Located In: Corner Code #
 Mason County
 Public Land Survey T 17N R 15W K-13
 T R
 T R
 T R
 Property Controlling S T R
 in Section S T R
 Miscellaneous S T R
 Property in Sec. S T R

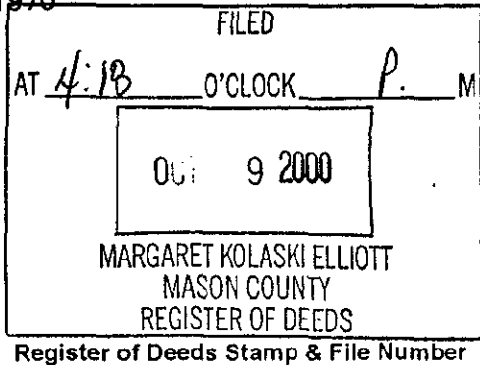

Lot No. _____, Recorded Plat _____
 Private Claims _____

	A	B	C	D	E	F	G	H	I	J	K	L	M
1													
2	6	5	4	3	2	1							
3													
4	7	8	9	10	11	12							
5													
6	18	17	16	15	14	13							
7													
8	19	20	21	22	23	24							
9													
10	30	29	28	27	26	25							
11													
12	31	32	33	34	35	36							
13													

Theodore H. Weinert, in a field survey on September 3, 2000, Do hereby certify that under requirements of P.A. 74, Michigan P.A. of 1970, the corner points mentioned in lines 1 and 2 above were in conformance with regulations and rules therefore as required in the current manual of survey instructions of the United States Department of the Interior, Bureau of Land Management or by a decree of a Court of Law and/or that the corner points mentioned in lines 4 and 5 above were in conformance with the rules of the Michigan Board of Land Surveyors by a Decree of a Court of Law; established, re-established, monumented, re-monumented, recovered, found as expressed below:

NOTE: Not more than 4 corners, all in the same town and range, may be recorded on this certificate.

Description of original monument and accessories and/or subsequent restoration:
 Corner Common to Sections 35 and 36, T.17N., R.15W

Original Government Survey done by Lulel and Brookfield, 1837
 9) P.P. NE, 58.24'
 1) W. Pine, 10°, N58°W, 10 links, (6.60')
 2) W. Pine, 10°, N55°E, 12 links, (7.92')
 Book 2, page 316, survey by R.E. Lunde 936, "Iron Pin and Stones"
 3) pine, N35°W, 53.7'
 4) Pine, N27° 40' E, 30.00'
 Survey by George Blass, 1971 Set T Iron"
 5) Guy Pole, N59°W, 58.24'
 3) P. Pole, S55°W, 56.85'
 7) Corner L-1, T.16N., R.15W., East, 2641.59'
 3) Corner K-1, T.16N., R.15W., West, 16.50'
 Mason County Road Commission Record 1968, "Found Iron Pin"
 (12) Corner L-13, East, 2649.84'
 (10) P.P. SW, 56.85'
 (11) Fence Post, South, 34.7'
 R.A. Griffin, RLS, 13584 LCRC Liber 1, page 226, June 6, 1973
 Replaced the T iron with a 5" square concrete monument 36" in length with a brass disk.
 (8) Corner K-1, T.16N., R.15W., West, 16.50'
 (9) RLS tag, 13584 NW side of P.P. S53°W, 54.15'
 (10) 4" sq X 7" Post, N45°W, 46.60'
 (11) Corner K-12, T.17N., R.15W., North, 2602.66'
 (12) Corner L-13, T.17N., R.15W., East, 2649.84'

Survey by Sammy Barnett, 07/28/1978 Tied this Corner, No Witnesses Given.

Survey by Kenneth L. Ross, PLS 17634 Tied This Corner, 5/17/1982 No Witnesses Given (13) Distance to J-13, T.17N., R.15W., West, 2634.76'


Description of corner evidence found and/or method applied in restoring or reestablishing corner:
 Corner Common to Sections 35 and 36, T.17N., R.15W

Found the 5" square Monument as described by Griffin above, inside a Monument Box, in the center-line of Washington and Masten Roads. Witnesses (1) through 7) have been destroyed. Witnesses (8) through (13) are in good condition. I found no other evidence to dispute the location of this corner.

Description of monument for corner and accessories established to perpetuate locating the position of the corner:
 Corner Common to Sections 35 and 36, T.17N., R.15W

Left the 5" square Concrete Monument in place inside the Monument Box in the Center-line of Washington and Masten Roads. This corner accepted as a careful and faithful re-establishment of the position of the original corner.
 8) Corner K-1, T.16N., R.15W., West, 16.50'
 9) Existing nail and RLS brass tag #13584, NW side of P.P. S53°W, 54.15'
 10) Existing nail and RLS brass tag #13584, NE side of 4" square post, N45°W, 46.60'
 11) Corner K-12, T.17N., R.15W., North 2602.63' (measured EDM, 09/03/00)
 12) Corner L-13, T.17N., R.15W., East 2648.80' (measured EDM, 09/03/00)
 13) Corner J-13, T.17N., R.15W., West, 2634.76 (measured EDM, 09/03/00)

Signed by Theodore H. Weinert Date 10/6/00
 Theodore H. Weinert

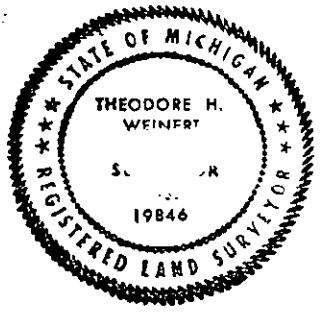

Surveyor's Michigan License No. 19846
 Approved by Peer Review Group on 10/15/00
 Kenneth L. Ross, County Representative