

SURVEY & REMONUMENTATION

MAR 16 1998

LAND CORNER RECORDATION CERTIFICATE

Filing Requirement of Act 74, Mich. P.A. 1970

SECTION

For corners in
MASON (County)
 Located In: Corner Code #


1. Public Land Survey T 17N R 17W
 T 17N R 16W
 T R
 T R

2. Property Controlling S T R
 in Section S T R

3. Miscellaneous S T R

Property in Sec. S T R

M-4
 A-4

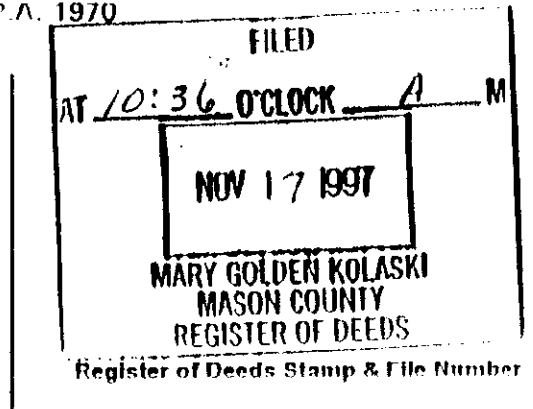

4. Lot No. Recorded Plat
 5. Private Claims

1	A	B	C	D	E	F	G	H	I	J	K	L	M
2		6		5		4		3		2		1	
3													
4	(1)	7		8		9		10		11		12	(1)
5													
6		18		17		16		15		14		13	
7													
8		19		20		21		22		23		24	
9													
10		30		29		28		27		26		25	
11													
12		31		32		33		34		35		36	
13													

I, **THEODORE H. WEINERT**, In a field survey on **SEPTEMBER 16, 1997**, do hereby certify that under requirements of P.A. 74, Michigan P.A. of 1970, the corner points mentioned in lines 1 and 2 above were in conformance with regulations and rules therefore as required in the current manual of survey instructions of the United States Department of the Interior, Bureau of Land Management or by a decree of a Court of Law and/or that the corner points mentioned in lines 3, 4, and 5 above were in conformance with the rules of the Michigan Board of Land Surveyors or by a Decree of a Court of Law, established, re-established, monumented, re-monumented, recovered, found as expressed below

NOTE: Not more than 4 corners, all in the same town and range, may be recorded on this certificate.

A. Description of original monument and accessories and/or subsequent restoration:

Corner Common to Section 12, T. 17N., R. 17W. and Section 7, 17N., R. 16W., Township lines and Original Corner established by Mullet and Brookfield, July, 1837. Set quarter section post, witnesses given, (1) Beech, 10", N 62° W, 6 links, (3.96') (2) Hemlock, 12", S 34° W, 39 links, (25.74'), C. E. Mitchell, 1911, MCRC records, tied this corner, does not state what he found, no witnesses given, distance north to corner M-3, 2633', distance south to corner M 5, 2633', Kenneth B. Stephens, RLS, 1961, drawing number B-42, stated set spike at this location, no witnesses given, distance West to Corner K 4, 5163.44' Kenneth B. Stephens, RLS, drawing number B-67, states set spike at this location in 1961, same distance to corner K 4 as above, no witnesses given, Mason County Road Commission Records, 1966, state iron, set monument box, witnesses given, (3) pipe, N 45° W, 46.67', (4) pipe, S 45° W, 46.67', (5) pipe East, 33.00', Kenneth L. Ross, RLS, 1980, drawing number B 145, state monument box at this location, no witnesses given, Distance South to corner M 5, 2635.35', Kenneth L. Ross, RLS, 1985, drawing number B-186, tied this corner no witnesses given and or distances to government corners, Kenneth L. Ross, RLS, 1992, drawing number 92061S, states monument box at this location, no witnesses given, distance north to M 3, 2633.09', distance south to corner M 5, 2635.34', distance West to corner K-4, 5161.78', Kenneth L. Ross, RLS, 1996, drawing number 96133S, states iron in monument box, no witnesses given, distance south to corner M-5, 2636.35', no other witnesses found during research of this corner

B. Description of corner evidence found and/or method applied in restoring or reestablishing corner:

I found a 2" O. D. pipe (3" below the road surface), in a monument box, on the center line of Scottville Road and the center line of Kistler Road to the West, old occupation to the east, Witnesses (1) through (4) have been removed or destroyed. Witness (5) remains in place and in excellent condition.

C. Description of monument for corner and accessories established to perpetuate locating the position of the corner:

I left the 2" O. D. pipe in place in the described monument box on the center-line of Scottville Road and the center line of Kistler Road to the West, and accepted this as the best available evidence of the location of the original corner. Witnesses checked or taken:

- (5) 1" pipe, N 90° E, 33.01'
- (6) Set spike in Power Pole (telephone box by it) N 42° W, 45.71'
- (7) Set spike in Guy Pole, N 50° E, 44.91'
- Nothing else to witnesses to within 300-400 feet of this corner.
- (8) Distance North to Corner M-3, 2633.12' (verified 9/23/97)
- (9) Distance South to Corner M-5, 2636.38' (verified 9/23/97)

Signed by *Theodore H. Weinert*

Date *10/2/97*

Surveyor's Michigan License No. 19846

FORM APPROVED BY MICHIGAN STATE BOARD OF LAND SURVEYORS

1997 20 1023

Peer Group Reviewed and Accepted
 Date *Oct 21, 1997*
[Signature]
 M.A.S. 11/1/97

REVISED MAY 14, 1995
 REPEALED 1997, 1997